# IREDELL COUNTY HEALTH DEPARTMENT

STATESVILLE 704-878-5305 (a) MOORESVILLE 704-664-5281

## IMPROVEMENT PERMIT / AUTHORIZATION TO CONSTRUCT / OPERATION PERMIT / EXISTING SYSTEM INSPECTION

PERMIT# 121583 PIN# 4747-66-2035 DATE 7/8/04

OWNER OR CONTRACTOR Michael L. Levan PHONE: Business (704) 902-6866 Home (704) 873-9180

ADDRESS P.O. Box 1717 Statesville, N.C. 28687

LOCATION 21 N. (L) White Farm Rd, (R) on Lonsdale Drive lot, 7th lot on left

SUBDIVISION Lonsdale BLOCK / SECTION I LOT 7 LOT AREA ±.70 Acres SITE CLASS. PS DESIGN FLOW 360 L.T.A.R. .30 gpd/ft2

Septic Tank: 1,000 Gallons; STB 1007 Date 4-4-05
Pump Tank: ____ Gallons; PT ____ Date ____
Pump Make: ____ Model ____ Serial No. ____
Nitrification Field: No Fields 1 Square Feet 1200 Linear Feet 400
No Lines 6 Trench Width 36" Max Trench Bottom Depth 30" Gravel Depth 12"

☒ New System ☐ Repair System Type: I, (II), III, IV, V, VI
System Description: Gravity, Conventional
Repair System Description: Pump 25% Reduction
Maintenance Agreement Required: ☐ Yes ☐ No


☒ House/Mod. Home No. Bedrooms 3
☐ Mobile Home No. Bathrooms 2
☐ Business No. Employees ____
☐ Other ____
☐ Slab ☒ Crawl Space ☐ Basement w/plumbing ☐ Basement wo/plumbing

Water Supply: ☐ Individual ☒ Public ☐ Community

Comments:/Conditions: ① Install lines on contour

Comments:/Conditions: SEPTIC TANK WITH MARKER INSTALLED ~~ACCORD~~ USING "ZABEL" FILTER

INITIAL SITE SKETCH (Not to Scale)

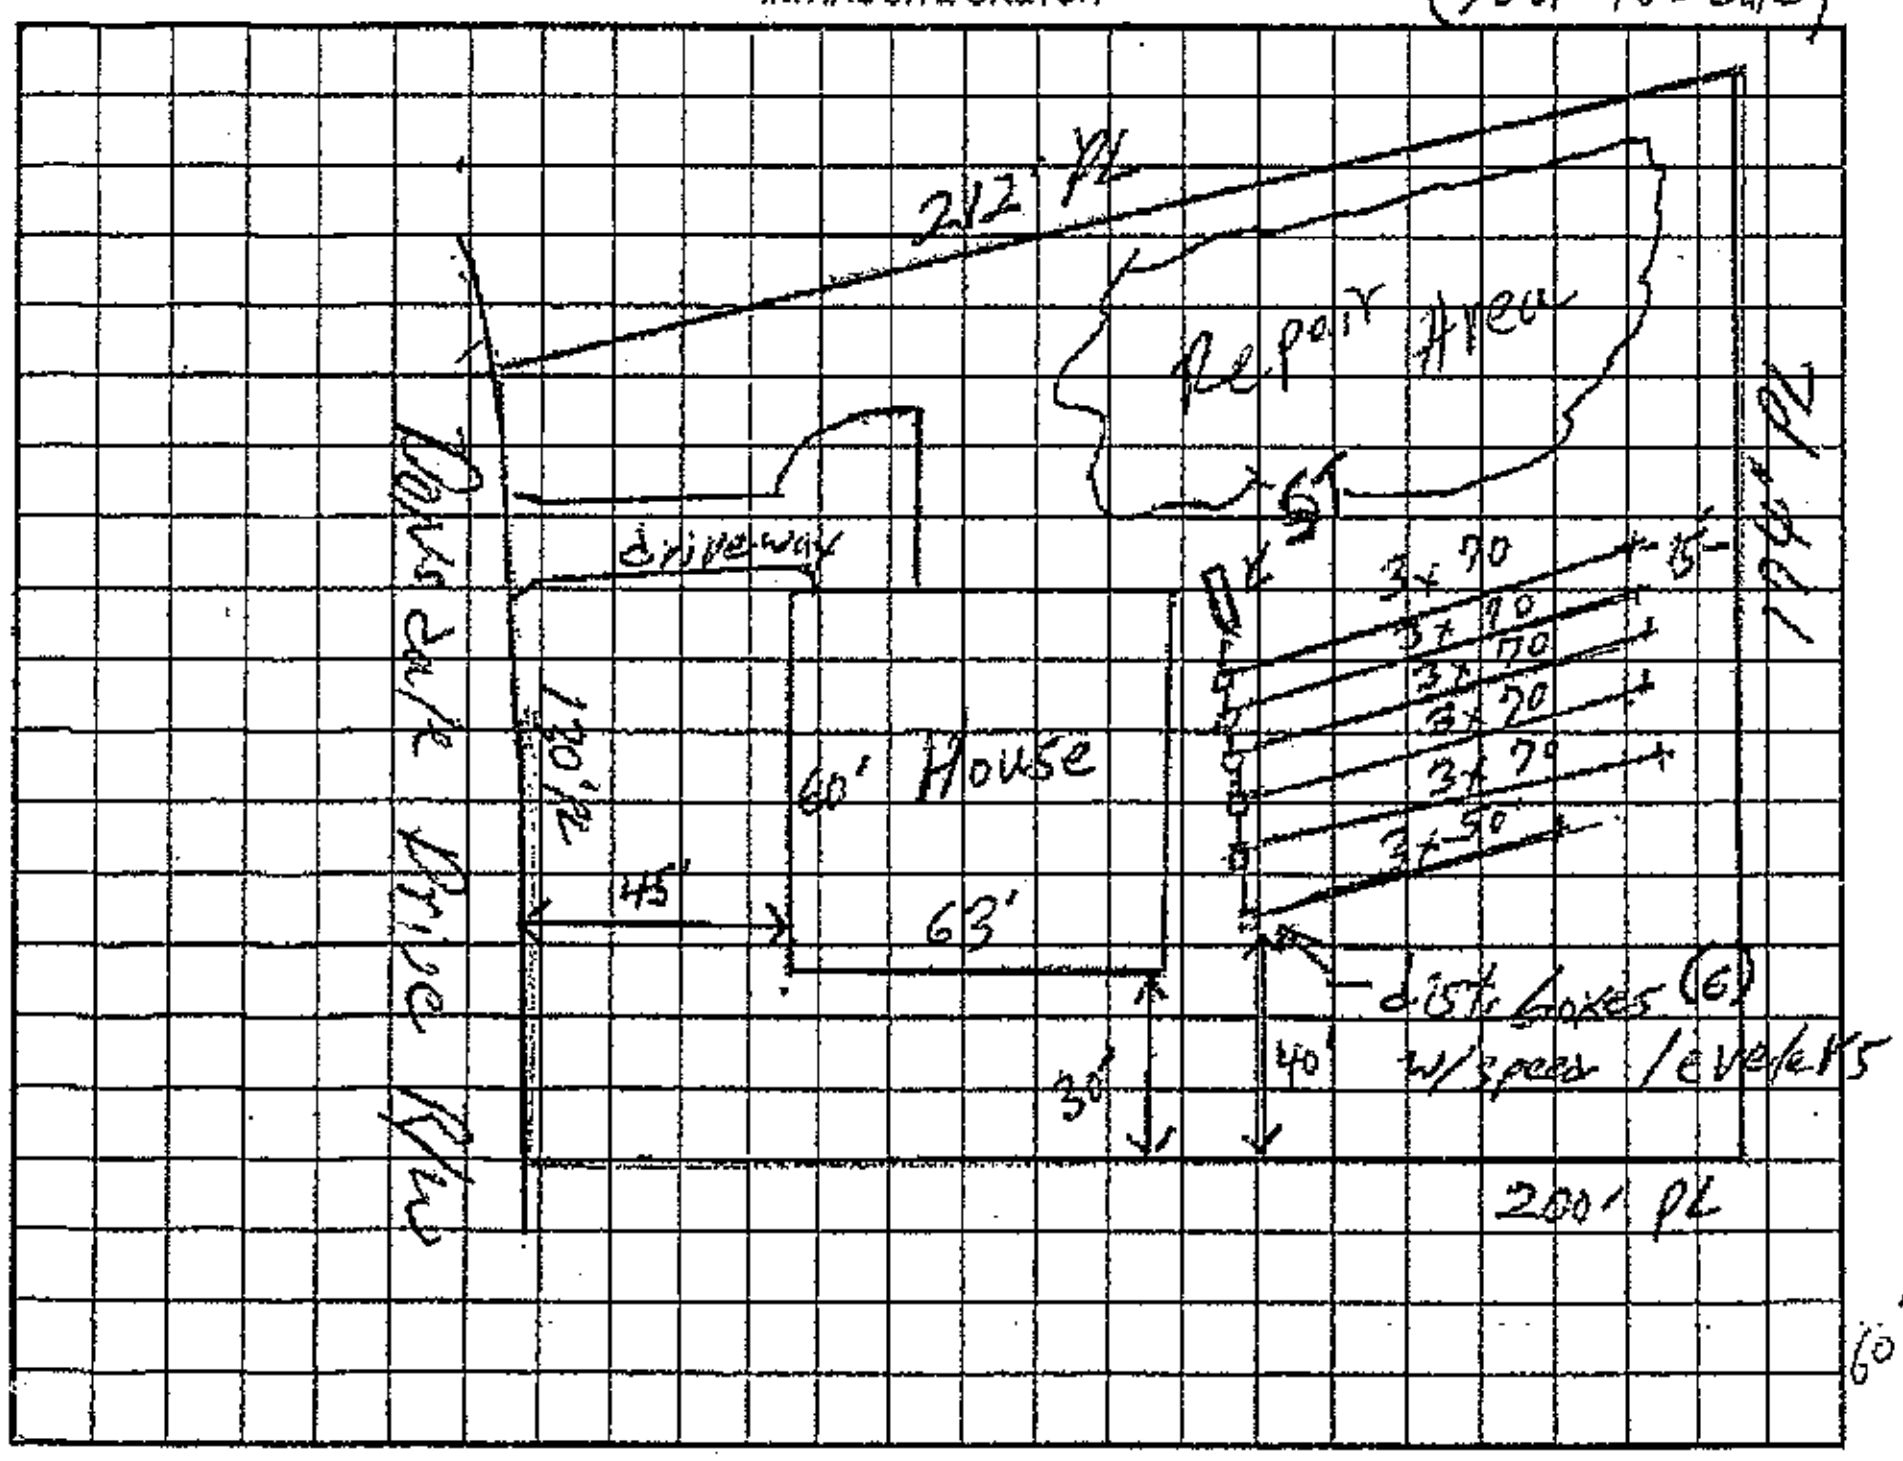


AS BUILT SKETCH

SYSTEM INSTALLED ACCORDING TO INITIAL SITE SKETCH

**Location of the proposed** SCREENED PORCH **addition does not appear to impact the existing on-site septic system.**NOTE:** KEEP MIN 5' FROM SYSTEM
R. STEVE HEDRICK **REHS**
**Date:** OCTOBER 16, 2012
**ICHD-Environmental Health Division**

Permit can be suspended or revoked if any false information is supplied toward securing the permit/any unauthorized changes are made to the site/any unauthorized changes are made in the installation of the system. Improvement Permit with plat valid without expiration. Improvement Permit with site plan valid for sixty months. Authorization to Construct is valid for a period equal to that of Improvement Permit – not to exceed sixty months.

Signed: [signature] date 7/8/04
Improvement Permit by: William O. Johnson date 7/8/04
Authorization to Construct by: William O. Johnson date 7/8/04

Installed by: JAMES HUDLER
Operation Permit by: STEVE HEDRICK date 5-10-05
Existing System Inspection by: ____ date ____

HEALTH DEPT. COPY: WHITE OWNER COPY (FINAL): YELLOW OWNER COPY (INITIAL): PINK