IREDELL COUNTY HEALTH DEPARTMENT

STATESVILLE 704-878-5305 MOORESVILLE 704-664-5281

IMPROVEMENT PERMIT / AUTHORIZATION TO CONSTRUCT / OPERATION PERMIT / EXISTING SYSTEM INSPECTION

DATE 01-17-01

PERMIT# 93802 PIN# 4747 79 5555 PHONE: Business _____ Home 876-2030

OWNER OR CONTRACTOR ARCHIE BRIDGES

ADDRESS BLACKWELDER RD, STATESVILLE, NC 28625

LOCATION HWY 21 N, @ JENNINGS, @ Blackwelder Rd 3/4 mile on Left

SUBDIVISION _____ BLOCK / SECTION _____ LOT _____ LOT AREA 6 AC SITE CLASS PS DESIGN FLOW 240 gpd L.T.A.R. 133 gpd/442

Septic Tank: 1000 Gallons; STB _____ Date _____

Pump Tank: _____ Gallons; PT _____ Date _____

Pump Make: _____ Model _____ Serial No _____

Nitrification Field: No Fields 1 Square Feet _____ Linear Feet _____

No Lines 2 Trench Width 36" Max Trench Bottom Depth _____ Gravel Depth 12"

☐ New System ☐ Repair System Type: I, II, III, IV, V, VI

System Description: EXISTING CONV GRAY

Repair System Description: CONV GRAY

Maintenance Agreement Required: ☐ Yes ☒ No

☐ House/Mod. Home ☒ Mobile Home ☐ Business ☐ Other

No. Bedrooms 2 No. Bathrooms 1 No. Employees _____

☐ Slab ☒ Crawl Space ☐ Basement w/plumbing ☐ Basement wo/plumbing

Water Supply: ☒ Individual ☒ Public ☐ Community


7430-31

Comments/Conditions: ① PUT MOBILE HOME EXACTLY WHERE OLD ONE WAS

Comments/Conditions:

INITIAL SITE SKETCH

AS BUILT SKETCH

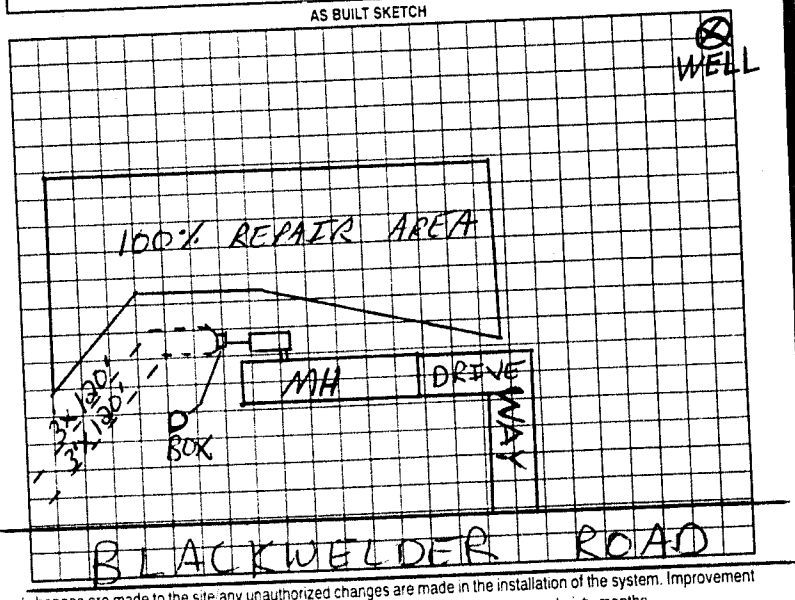

Permit can be suspended or revoked if any false information is supplied toward securing the permit/any unauthorized changes are made to the site/any unauthorized changes are made in the installation of the system. Improvement Permit with plat valid without expiration. Improvement Permit with site plan valid for sixty months. Authorization to Construct is valid for a period equal to that of Improvement Permit – not to exceed sixty months.

Signed: _____ date _____

Improvement Permit by: _____ date _____

Authorization to Construct by: _____ date _____

Installed by: _____

Operation Permit by: _____ date _____

Existing System Inspection by: [signature] RST date 01/17/01

HEALTH DEPT COPY WHITE OWNER COPY (FINAL) YELLOW OWNER COPY (INITIAL) PINK