IREDELL COUNTY HEALTH DEPARTMENT

STATESVILLE 704-878-5305 CI MOORESVILLE 704-664-5281

IMPROVEMENT PERMIT / AUTHORIZATION TO CONSTRUCT / OPERATION PERMIT / EXISTING SYSTEM INSPECTION

PERMIT# 104778 PIN# 4747-81-9097 DATE 03-20-02

OWNER OR CONTRACTOR RICHARD SIMMONS WELL DRILLING PHONE: Business 704-876-6685 Home 704-202-5121

ADDRESS 60 DRILL RIG DRIVE BUCHANON, VA 24066

LOCATION HWY 21 N, (L) JENNINGS, ON LEFT RIGHT AROUND FIRST CURVE (3RD BUSINESS ON LEFT)

SUBDIVISION _____ BLOCK / SECTION _____ LOT _____ LOT AREA 9.39 AC SITE CLASS PS DESIGN FLOW 250 L.T.A.R. .3

Septic Tank: 1000 Gallons: STB 1012 Date 12-18-01

Pump Tank: _____ Gallons: PT _____ Date _____

Pump Make: _____ Model _____ Serial No _____

Nitrification Field: No Fields 1 Square Feet 602.77 Linear Feet 200'

No Lines 4X50' Trench Width 36" Max Trench Bottom Depth 26"

X New System ☐ Repair System Type: I. II. (III) IV. V. VI

System Description: CONV GRAV

Repair System Description: GRAV PANEL

Maintenance Agreement Required: ☐ Yes X No

Gravel Depth N/A

X Slab ☐ Crawl Space ☐ Basement w/plumbing ☐ Basement wo/plumbing

☐ House/Mod. Home No. Bedrooms 4 (3 BEDROOMS)

☐ Mobile Home No. Bathrooms 2

X Business No. Employees 10


☐ Other 10 EMPLOYEE'S

Water Supply: ☒ Individual ☐ Public ☐ Community WELL


Comments/Conditions: (1) SAND IS NOT REQUIRED, BUT OWNER WANTS IT IF CHAMBERS ARE USED. (2) OWNER IS GOING TO SUPPLY SCH 80 PVC TO ENCASE THE SUPPLY LINE UNDER DRIVEWAY (3) KEEP ALL WELLS

Comments/Conditions: INCLUDING GEOTHERMALS 100' AWAY FROM SEPTIC REPAIR AREA. (4) INSTALL LINES ON CONTOURS & MAINTAIN SETBACKS (5) THIS PROPERTY HAS A LOT OF FILL DIRT ON IT.

INITIAL SITE SKETCH "NOT TO SCALE"

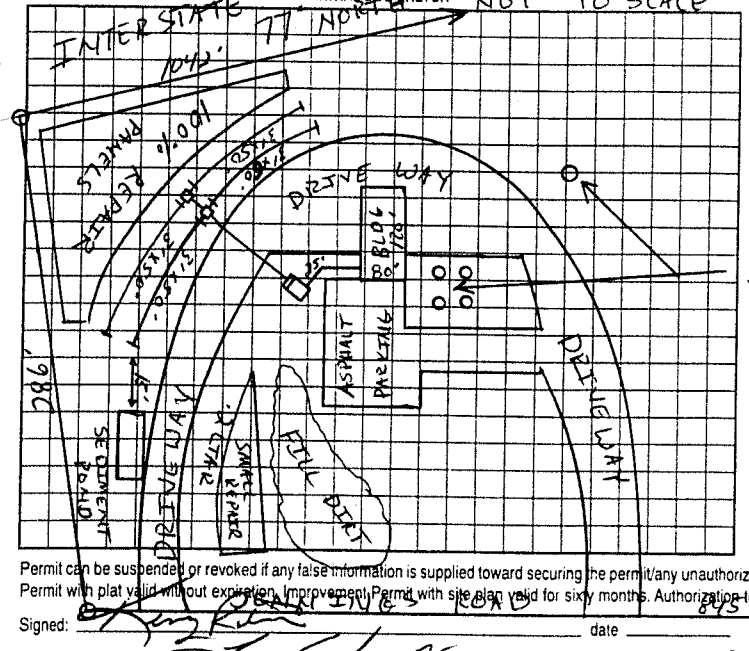

AS BUILT SKETCH

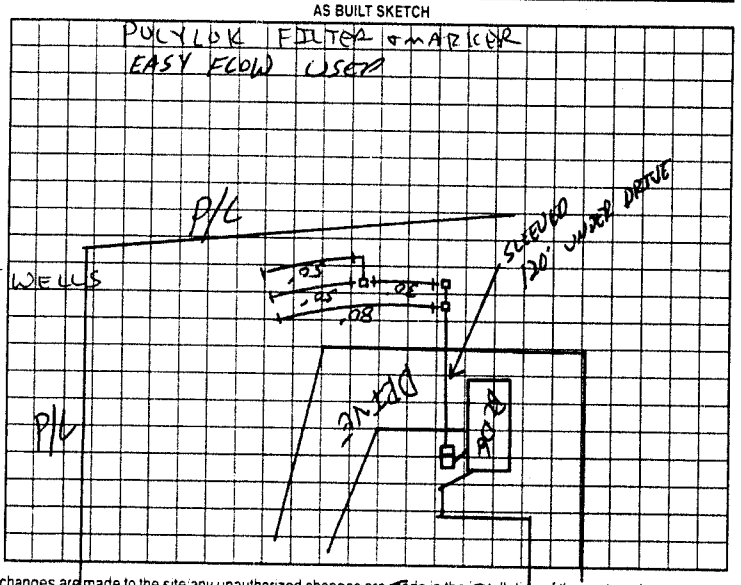

Permit can be suspended or revoked if any false information is supplied toward securing the permit/any unauthorized changes are made to the site/any unauthorized changes are made in the installation of the system. Improvement Permit with plat valid without expiration. Improvement Permit with site plan valid for sixty months. Authorization to Construct is valid for a period equal to that of Improvement Permit not to exceed sixty months.

Signed: _____ date _____ Installed by: A-1 BACKHOE

Improvement Permit by: _____ date 03-20-02 Operation Permit by: _____ date 05-01-02

Authorization to Construct by: _____ date 03-20-02 Existing System Inspection by: _____ date _____

HEALTH DEPT COPY WHITE OWNER COPY (FINAL) YELLOW OWNER COPY (INITIAL) PINK