IREDELL COUNTY HEALTH DEPARTMENT

STATESVILLE 704-878-5305 (C1) MOORESVILLE 704-664-5281

IMPROVEMENT PERMIT / AUTHORIZATION TO CONSTRUCT / OPERATION PERMIT / EXISTING SYSTEM INSPECTION

PERMIT# 117053 PIN# 4747-84-8714 2809 DATE 11-25-03

OWNER OR CONTRACTOR RAY SNORT PHONE: Business 704-202-5568 Home 704-876-4792 (JAMES LEWIS)

ADDRESS P.O. BOX 1792, MOORESVILLE, NC 28117

LOCATION US 21 NORTH, TL JENNINGS ROAD, 0.8 MILE ON LEFT

SUBDIVISION ~~CAMPBELL~~ BLOCK / SECTION LOT LOT AREA AMPLE SITE CLASS PS DESIGN FLOW 300 L.T.A.R. 0.25 GPD/FT²

Septic Tank: 1000 Gallons; STB 312 Date 7-7-05
Pump Tank: Gallons; PT Date
Pump Make: Model ~~ZOE~~ TO Serial No. 300
Nitrification Field: No Fields 1 Square Feet 1200 Linear Feet ~~400~~
No Lines THREE Trench Width 36" Max Trench Bottom Depth 36" Gravel Depth 12"

☑ New System ☐ Repair System Type: I, II, III, IV, V, VI (C1)
System Description: CONVENTIONAL GRAVITY
Repair System Description: CONVENTIONAL, PUMP
Maintenance Agreement Required: ☐ Yes ☑ No

☐ House/Mod. Home No. Bedrooms
☐ Mobile Home No. Bathrooms
☐ Business No. Employees
☑ Other CHURCH W/100 SEATS


Water Supply: ☐ Individual ☑ Public ☐ Community

☑ Slab ☐ Crawl Space ☐ Basement w/plumbing ☐ Basement w/o plumbing (2) BASEMENT/CRAWL SPACE


Comments:/Conditions: KEEP ELEVATION OF PLUMBING AT LEVEL TO MAINTAIN GRAVITY FLOW (PUMP SYSTEM TO BE REQUIRED IF GRAVITY FLOW NOT MAINTAINED AT REQUIRED DEPTH

Comments:/Conditions: (1) SEPTIC TANK WITH RISERS & MARKER INSTALLED USING "RED-POLYLOK" FILTER (2) SYSTEM ALTERED AS SHOWN WITH PRIOR HEALTH DEPARTMENT APPROVAL

INITIAL SITE SKETCH

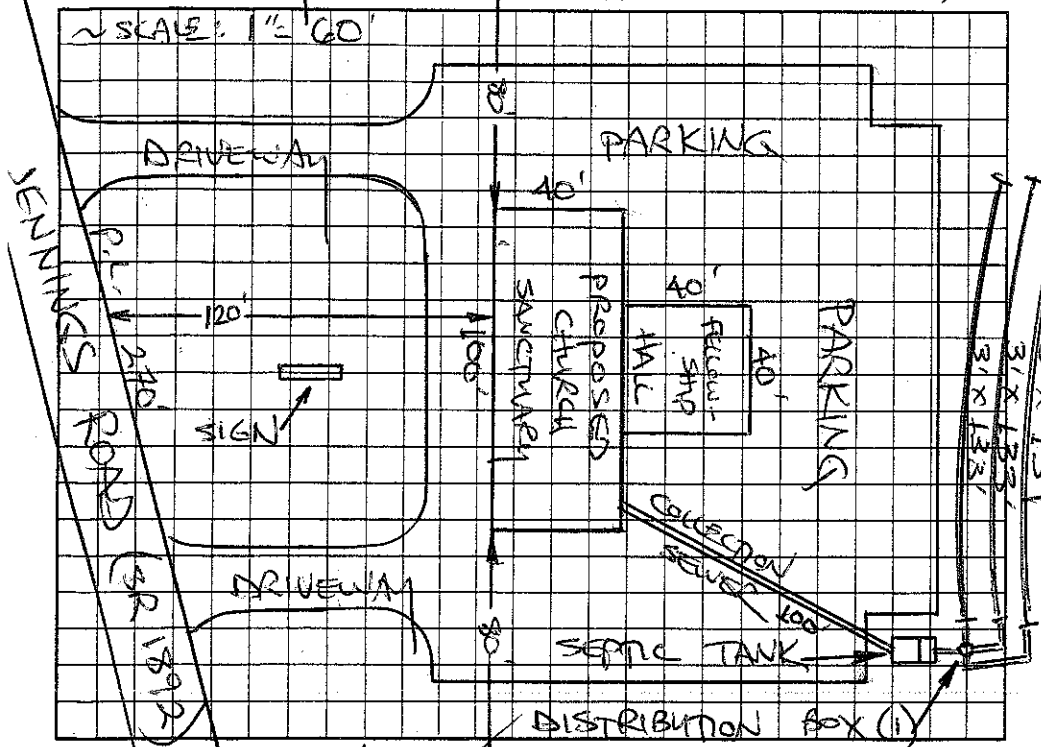

AS BUILT SKETCH

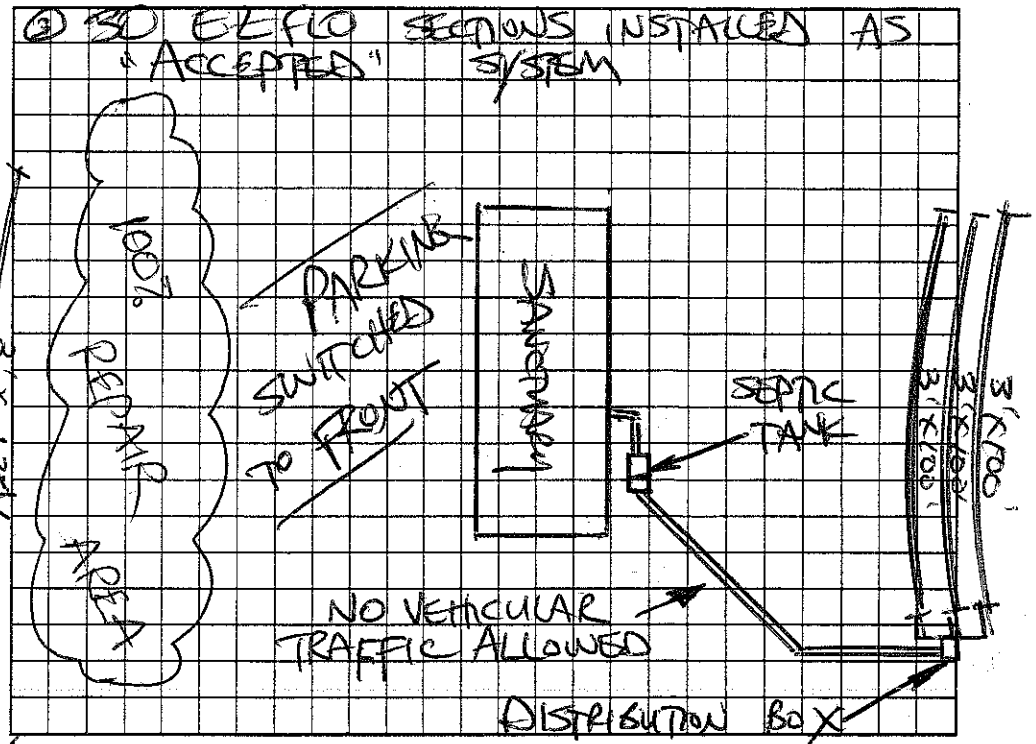

Permit can be suspended or revoked if any false information is supplied toward securing the permit/any unauthorized changes are made to the site/any unauthorized changes are made in the installation of the system. Improvement Permit with plat valid without expiration. Improvement Permit with site plan valid for sixty months. Authorization to Construct is valid for a period equal to that of Improvement Permit – not to exceed sixty months.

Signed: date 11-25-03 Installed by: HOWARDS BACKHOE

Improvement Permit by: STEVE HEDRICK date 11-25-03 Operation Permit by: STEVE HEDRICK date 8-22-05

Authorization to Construct by: STEVE HEDRICK date 11-25-03 Existing System Inspection by: date

HEALTH DEPT: COPY: WHITE OWNER COPY (FINAL): YELLOW OWNER COPY (INITIAL): PINK