51765

IREDELL COUNTY HEALTH DEPARTMENT STATESVILLE 704-878-5305 MOORESVILLE 704-664-5281

IMPROVEMENT PERMIT / CERTIFICATE OF COMPLETION / OPERATION PERMIT / EXISTING SYSTEM INSPECTION

PROPERTY DESCRIPTION NO 18719 DATE 6-10-94 TAX MAP NO 10K-A-82 Watershed ☐ Yes ☐ No

OWNER OR CONTRACTOR Tiffany Patterson PHONE: Business Home 876-6416

ADDRESS R-4 Box 345-N Statesville

LOCATION US 21 N TL Jennings Rd Rt Exit I-77 Brittain on Rt. 73

SUBDIVISION BLOCK SECTION LOT LOT AREA .7 acres SITE CLASS PS DESIGN FLOW 360 LTAR .33

Septic Tank 1000 Gallons STB 1012 Date 5/22/94 | New System Repair System Type Conv. Gravity | Home/Mod Home No Bedrooms 3 | Water Supply: ☐ Individual ☐ Community ☐ Public

Pump Tank Gallons PT Date | System Description 1 | Mobile Home No Bathrooms 2

Pump Make Model Serial No | Repair System Description | Business No Employees


Number of Bedrooms 3 Square Feet 1080 Total Feet 340 | Maintenance Agreement Required Yes No | Other

No. Lines 4 Trench Width 36" Min. Bottom Depth 36" Gravel Depth 12" | Slab Crawl Space Basement w/plumbing Basement w/o plumbing


Comments

Comments

INITIAL SITE SKETCH

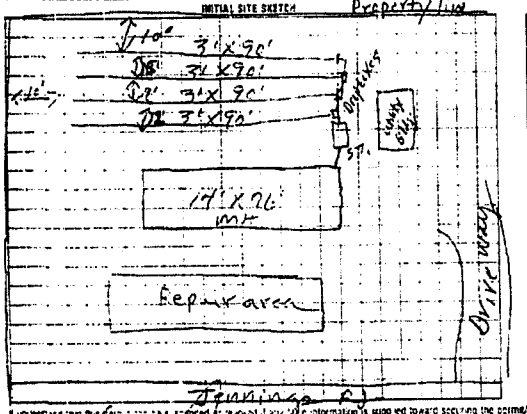

AS BUILT SKETCH

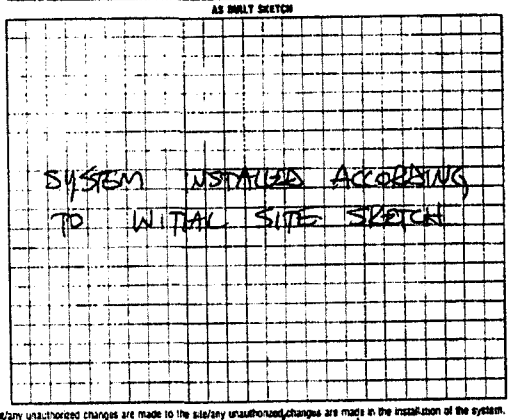

I understand that a permit may be issued on the basis of this information is supplied toward securing the permit/any unauthorized changes are made to the site/any unauthorized changes are made in the installation of the system. Improvement Permit is valid for 60 months from date of issuance

Signed [signature] Improvement Permit by D. C. Hunter date 6-10-94

Existing System Inspected by date

Installed by Jeff Hulbut / Jr. Harness

Certificate of Completion by Steve Hedrick date 6/16/94

Operation Permit by date

HEALTH DEPT COPY (WHITE) SANITARIAN COPY (FINAL) CANARY OWNER COPY (FINAL) YELLOW INSPECTION COPY (INITIAL) PINK OWNER COPY (INITIAL) GOLD

JAN. 23, 1989 17:51