# IREDELL COUNTY HEALTH DEPARTMENT

STATESVILLE 704-878-5305 (c) MOORESVILLE 704-664-5281

## IMPROVEMENT PERMIT / AUTHORIZATION TO CONSTRUCT / OPERATION PERMIT / EXISTING SYSTEM INSPECTION

(c)

PERMIT# 109262 PIN# 4747-89-~~0102.2~~ 0130 DATE 10-30-02

OWNER OR CONTRACTOR BUHRMASTER CONSTRUCTION PHONE: Business 704-872-2279 Home 704-902-5704

ADDRESS ~~[illegible]~~ 138 SEVEN SPRINGS LOOP, STATESVILLE, NC 28625

LOCATION US 21 N, TL JENNINGS ROAD, TR BLACKWELDER ROAD 0.5 MILE ON RIGHT

SUBDIVISION HUNTER GLEN BLOCK / SECTION ____ LOT 2 LOT AREA 1.260 ACRES SITE CLASS. PS' DESIGN FLOW 360 L.T.A.R. 0.25 GPD/FT²

Septic Tank: 1000 Gallons; STB 1012 Date 11-2-03

Pump Tank: ____ Gallons; PT ____ Date ____

Pump Make: ____ Model ____ Serial No. ____

Nitrification Field: No Fields 1 Square Feet 1440 Linear Feet 480

No Lines FOUR Trench Width 36" Max Trench Bottom Depth 36" Gravel Depth 12"

☑ New System ☐ Repair System Type: I, II, III, IV, V, VI

System Description: CONVENTIONAL, GRAVITY

Repair System Description: CONVENTIONAL, PUMP

Maintenance Agreement Required: ☐ Yes ☑ No

☑ House/Mod. Home No. Bedrooms 3

☐ Mobile Home No. Bathrooms 2

☐ Business No. Employees ____

☐ Other ____


☐ Slab ☑ Crawl Space ☐ Basement w/plumbing ☐ Basement wo/plumbing

Water Supply: ☐ Individual ☑ Public ☐ Community

Comments:/Conditions:

Comments:/Conditions: SEPTIC TANK WITH MARKER INSTALLED USING "TUFTITE" FITTER

INITIAL SITE SKETCH

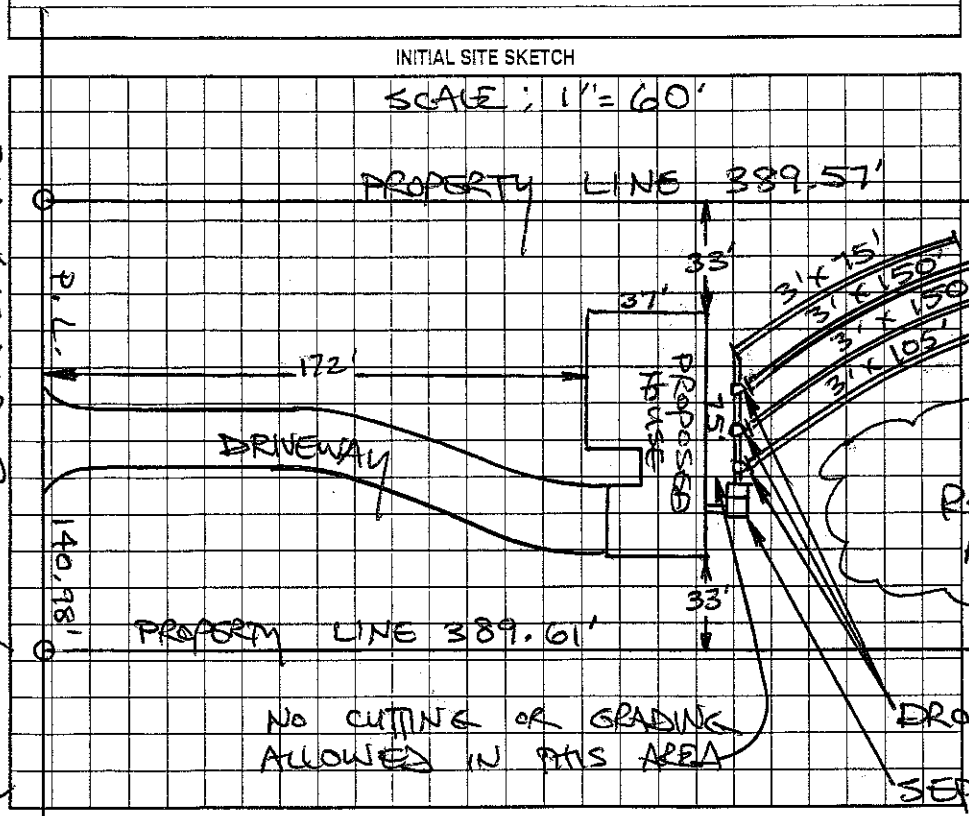


AS BUILT SKETCH

SYSTEM INSTALLED ACCORDING TO INITIAL SITE SKETCH

Permit can be suspended or revoked if any false information is supplied toward securing the permit/any unauthorized changes are made to the site/any unauthorized changes are made in the installation of the system. Improvement Permit with plat valid without expiration. Improvement Permit with site plan valid for sixty months. Authorization to Construct is valid for a period equal to that of Improvement Permit – not to exceed sixty months.

Signed: [signature] date 10-31-02 Installed by: PIEDMONT BACKHOE SERVICE

Improvement Permit by: STEVE HEDRICK date 10-30-02 Operation Permit by: STEVE HEDRICK date 4-30-04

Authorization to Construct by: STEVE HEDRICK date 10-30-02 Existing System Inspection by: ____ date ____

HEALTH DEPT. COPY: WHITE OWNER COPY (FINAL): YELLOW OWNER COPY (INITIAL): PINK