CI

IREDELL COUNTY HEALTH DEPARTMENT

STATESVILLE 704-878-5305 MOORESVILLE 704-664-5281

IMPROVEMENT PERMIT / AUTHORIZATION TO CONSTRUCT / OPERATION PERMIT / EXISTING SYSTEM INSPECTION

PERMIT# 104299 PIN# 4747-89-0102 DATE 2-5-02

OWNER OR CONTRACTOR BUHRMASTER BUILDERS PHONE Business Home 704-876-3803

ADDRESS 749 BLACKWELDER ROAD, STATESVILLE NC 28625

LOCATION US 21 N, TL JENNINGS ROAD, TR BLACKWELDER ROAD, 0.6 MILE ON RIGHT

SUBDIVISION BLOCK / SECTION LOT LOT AREA 3.79 ACRES (TOWN) SITE CLASS PS DESIGN FLOW 360 L.T.A.R. 0.25 GPD/FT²

Septic Tank: 1000 Gallons. STB 1012 Date 4-9-02

Pump Tank: Gallons; PT Date

Pump Make: Model Serial No.

Nitrification Field: No Fields 1 Square Feet 1440 Linear Feet 480

No Lines FOUR Trench Width 36" Max Trench Bottom Depth 36" Gravel Depth 12"

☑ New System ☐ Repair System Type: I II III IV V VI

System Description: CONVENTIONAL GRAVITY

Repair System Description: CONVENTIONAL, PUMP

Maintenance Agreement Required: ☐ Yes ☑ No

☐ Slab ☑ Crawl Space ☐ Basement w/plumbing ☐ Basement wo/plumbing

☑ House/Mod. Home No. Bedrooms 3

☐ Mobile Home No. Bathrooms 2

☐ Business No. Employees


☐ Other

Water Supply: ☐ Individual ☑ Public ☐ Community


Comments/Conditions:

Comments/Conditions TUFF TITE FILTER & MARKER INSTALLED AS SHOWN
SPEED LEVERS SET FEEDING 1, 2, 3 & 4.

INITIAL SITE SKETCH SCALE: 1" = 50'

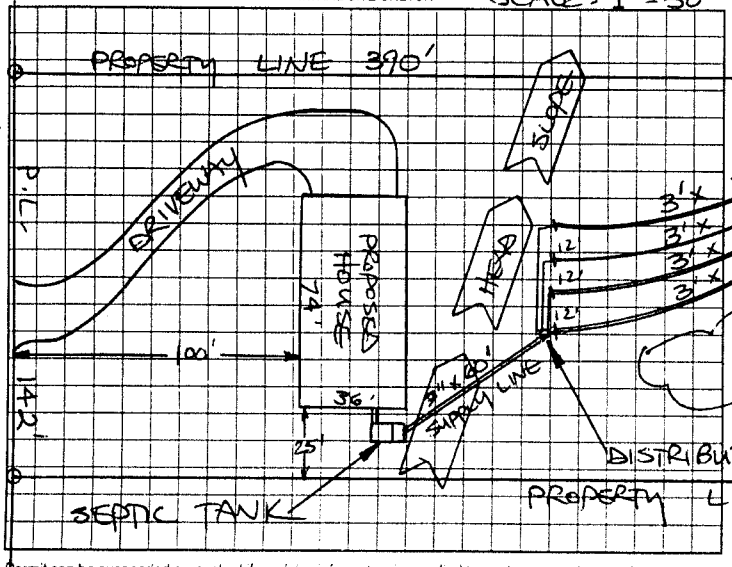

AS BUILT SKETCH

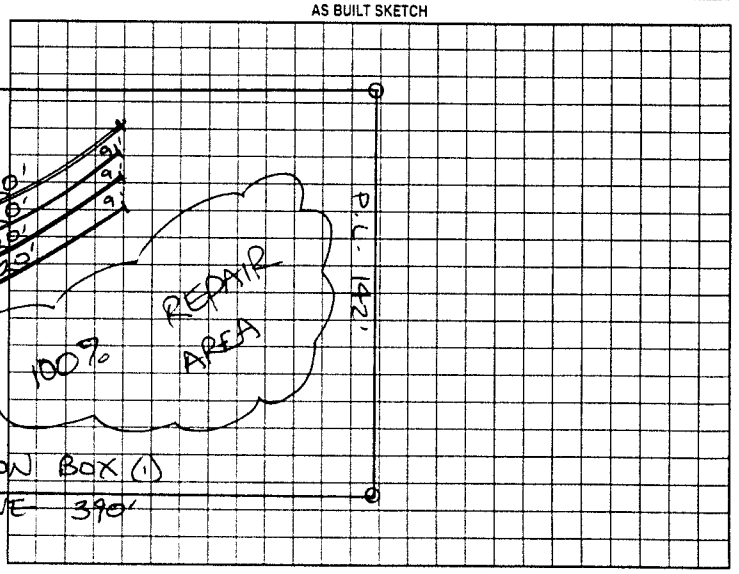

BLACKWELDER ROAD (SR 1914)

Permit can be suspended or revoked if any false information is supplied toward securing the permit/any unauthorized changes are made to the site/any unauthorized changes are made in the installation of the system. Improvement Permit with plat valid without expiration. Improvement Permit with site plan valid for sixty months. Authorization to Construct is valid for a period equal to that of Improvement Permit – not to exceed sixty months.

Signed: [signature] date 2-5-02 Installed by: STEVE JORDAIN

Improvement Permit by: STEVE HEDRICK date 2-5-02 Operation Permit by: [signature] date 9-19-02

Authorization to Construct by: STEVE HEDRICK date 2-5-02 Existing System Inspection by: date

HEALTH DEPT COPY WHITE OWNER COPY (FINAL) YELLOW OWNER COPY (INITIAL) PINK