300 -330

IREDELL COUNTY HEALTH DEPARTMENT

STATESVILLE 704-878-5305 MOORESVILLE 704-664-5281

IMPROVEMENT PERMIT / AUTHORIZATION TO CONSTRUCT / OPERATION PERMIT / EXISTING SYSTEM INSPECTION

PERMIT# 83681 PIN# 4747891506 DATE ~~8-16-99~~ 9-10-99

OWNER OR CONTRACTOR Eric Harrison PHONE: Business ____ Home 8761466

ADDRESS 111 Dove Cr. Statesville, N.C.

LOCATION 21N TL Jennings TR Blackwelder 1/4 to 1/2 mi Rt. (733 Blackwelder Rd)

SUBDIVISION ____ BLOCK / SECTION ____ LOT ____ LOT AREA 2.17 acres SITE CLASS PS DESIGN FLOW 360 L.T.A.R. .125

Septic Tank: 1000 Gallons; STB 1013 Date 6/27/00

Pump Tank: ____ Gallons; PT ____ Date ____

Pump Make: ____ Model ____ Serial No. ____

Nitrification Field: No Fields 1 Square Feet 1080 Linear Feet 360

No Lines 5 Trench Width 36" Max Trench Bottom Depth 24" Gravel Depth N/A

☑ New System ☐ Repair System Type: I II III IV V VI

System Description: Gravity 25% Rdn

Repair System Description: Pump to 25%

Maintenance Agreement Required: ☐ Yes ☐ No

☑ House/Mod. Home No. Bedrooms 3

☐ Mobile Home No. Bathrooms 2

☐ Business No. Employees ____

☐ Other ____


☐ Slab ☑ Crawl Space ☐ Basement w/plumbing ☐ Basement wo/plumbing

Water Supply: ☐ Individual ☐ Public ☐ Community


Comments/Conditions: POLYLOK FILTER INSTALLED

Comments/Conditions:

INITIAL SITE SKETCH

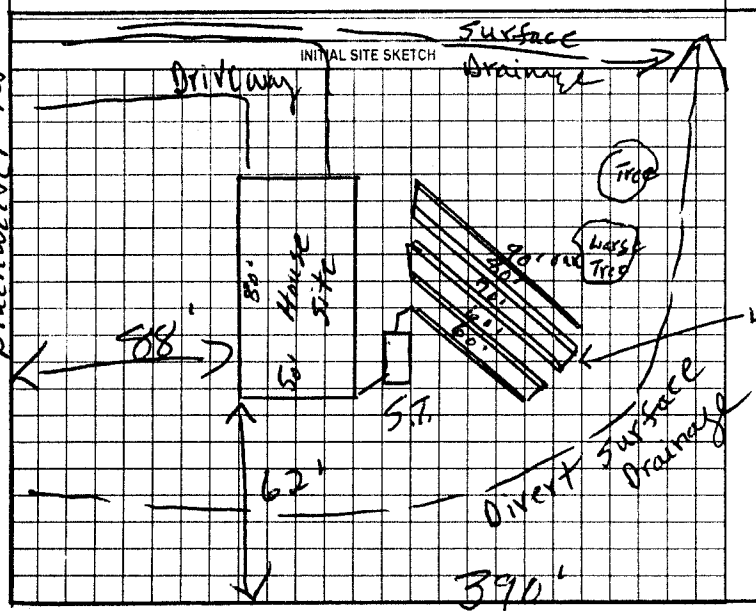

AS BUILT SKETCH

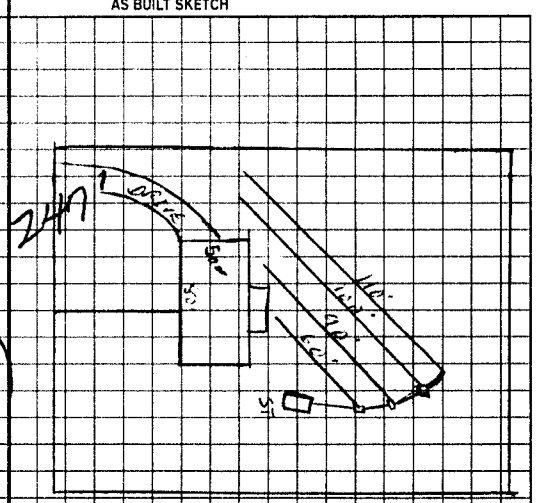

Permit can be suspended or revoked if any false information is supplied toward securing the permit/any unauthorized changes are made to the site/any unauthorized changes are made in the installation of the system. Improvement Permit with plat valid without expiration. Improvement Permit with site plan valid for sixty months. Authorization to Construct is valid for a period equal to that of Improvement Permit – not to exceed sixty months.

Signed: Eric Harrison date 3-6-00 Installed by: Timmy Frye

Improvement Permit by: P.C. Moore date 9-10-99 Operation Permit by: C. [illegible] RS date 11/20/00

Authorization to Construct by: P.C. Moore date 9-10-99 Existing System Inspection by: ____ date ____

HEALTH DEPT COPY WHITE OWNER COPY (FINAL) YELLOW OWNER COPY (INITIAL) PINK