CI

IREDELL COUNTY HEALTH DEPARTMENT

STATESVILLE 704-878-5305 MOORESVILLE 704-664-5281

IMPROVEMENT PERMIT / AUTHORIZATION TO CONSTRUCT / OPERATION PERMIT / EXISTING SYSTEM INSPECTION

PERMIT# 102002 PIN# DATE 9-24-02

OWNER OR CONTRACTOR SCOTT REID PHONE: Business Home 876-4998

ADDRESS 711 BLACKWELDER RD STATESVILLE NC 28625

LOCATION 21N (L) JENNINGS, (R) BLACKWELDER RD, (R) AT BUX # 711

SUBDIVISION BLOCK / SECTION LOT LOT AREA 1.77AC SITE CLASS PS DESIGN FLOW 100 L.T.A.R. .3

Septic Tank: 1000 Gallons; STB 1013 Date 4-6-02
Pump Tank: Gallons; PT Date
Pump Make: Model Serial No.
Nitrification Field: No Fields 1 Square Feet 333 Linear Feet 111'
No Lines 2x55' Trench Width 36" Max Trench Bottom Depth 36" Gravel Depth 12"

[X] New System [ ] Repair System Type: I (II) III IV V VI
System Description: CONV GRAV
Repair System Description: SAME
Maintenance Agreement Required: [ ] Yes [X] No


[ ] House/Mod. Home No. Bedrooms
[ ] Mobile Home No. Bathrooms
[ ] Business No. Employees
[X] Other GARAGE
[ ] Slab [X] Crawl Space [ ] Basement w/plumbing [ ] Basement wo/plumbing

Water Supply: [ ] Individual [X] Public [ ] Community


Comments/Conditions: (1) INSTALL LINES ON CONTOURS (2) MAINTAIN SETBACKS

Comments/Conditions:

INITIAL SITE SKETCH

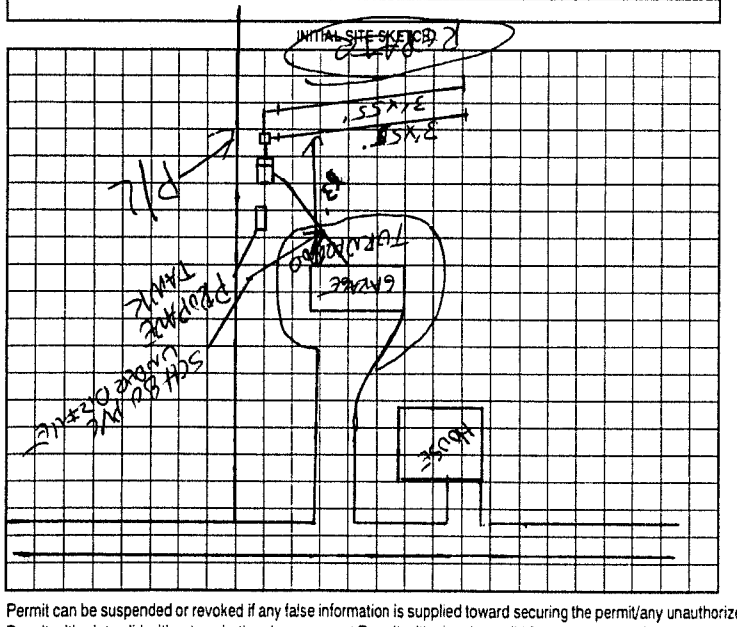

AS BUILT SKETCH

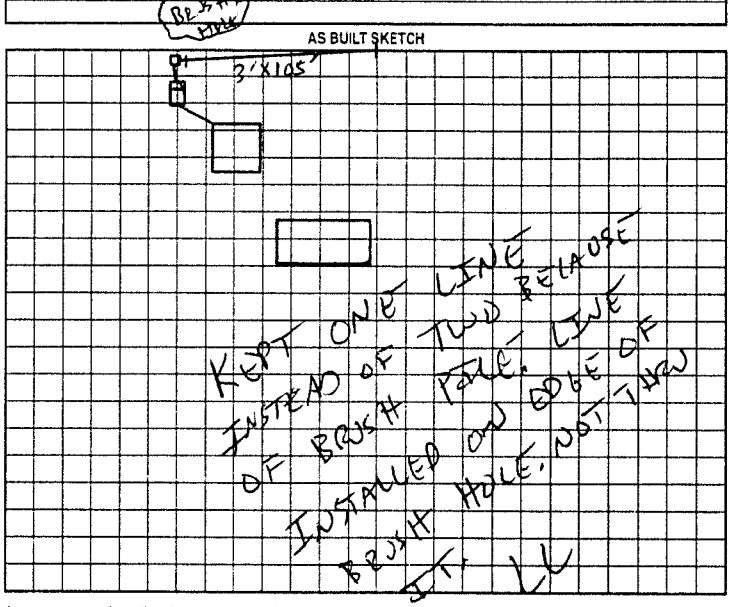

Permit can be suspended or revoked if any false information is supplied toward securing the permit/any unauthorized changes are made to the site/any unauthorized changes are made in the installation of the system. Improvement Permit with plat valid without expiration. Improvement Permit with site plan valid for sixty months. Authorization to Construct is valid for a period equal to that of Improvement Permit - not to exceed sixty months.

Signed: Scott Reid date 9-24-02 Installed by: STEVE JORDAN

Improvement Permit by: date 9-24-02 Operation Permit by: date 10-4-02

Authorization to Construct by: date 9-24-02 Existing System Inspection by: date

HEALTH DEPT COPY: WHITE OWNER COPY (FINAL) YELLOW OWNER COPY (INITIAL) PINK