IREDELL COUNTY HEALTH DEPARTMENT

STATESVILLE 704-878-5305 MOORESVILLE 704-664-5281

IMPROVEMENT PERMIT / AUTHORIZATION TO CONSTRUCT / OPERATION PERMIT / EXISTING SYSTEM INSPECTION

PERMIT# REPAIR PIN# 4747-90-7087 DATE 9-4-01

OWNER OR CONTRACTOR LAWS STAINED GLASS PHONE Business (704) 876-3463 Home

ADDRESS 145 EBENEZER LANE STATESVILLE NC 28625

LOCATION US 21 NORTH, TL ~~EBENEZER~~ ROAD, TR EBENEZER LANE, 2ND TRAILER ON RIGHT

SUBDIVISION BLOCK / SECTION JENNINGS LOT LOT AREA LIMITED SITE CLASS PS DESIGN FLOW 750 L.T.A.R. EXISTING

Septic Tank: EXISTING Gallons: STB Date

Pump Tank: Gallons: PT Date

Pump Make: Model Serial No

Nitrification Field: No Fields 1 Square Feet 900 Linear Feet 300

No Lines TWO Trench Width 36" Max Trench Bottom Depth 36" Gravel Depth 24"

☐ New System ☑ Repair System Type: IV

System Description:

Repair System Description: CONVENTIONAL GRAVITY

Maintenance Agreement Required ☐ Yes ☑ No

☐ House/Mod. Home ☐ Mobile Home ☑ Business ☐ Other

No. Bedrooms —

No. Bathrooms 3

No. Employees 30


☐ Slab ☐ Crawl Space ☑ Basement w/plumbing ☐ Basement wo/plumbing

Water Supply: ☐ Individual ☑ Public ☐ Community


Comments/Conditions: INSTALL NEW DISTRIBUTION BOX AT OUTLET END OF SEPTIC TANK ① AT NEW LINES, FEEDING NEW LINES FIRST ② INSTALL NEW SANITARY TEE IN SEPTIC TANK ③ USE 24" STONE IN NEW LINES.

Comments/Conditions: THIS PERMIT SERVES AS "NOTICE OF VIOLATION" .1961(a)(1)(B) SYSTEM TO BE REPAIRED BY OCTOBER 1, 2001

INITIAL SITE SKETCH

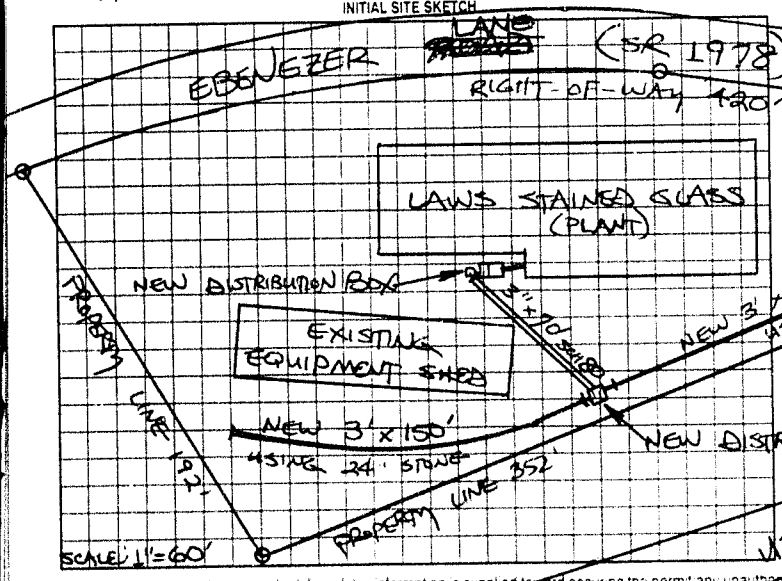

AS BUILT SKETCH

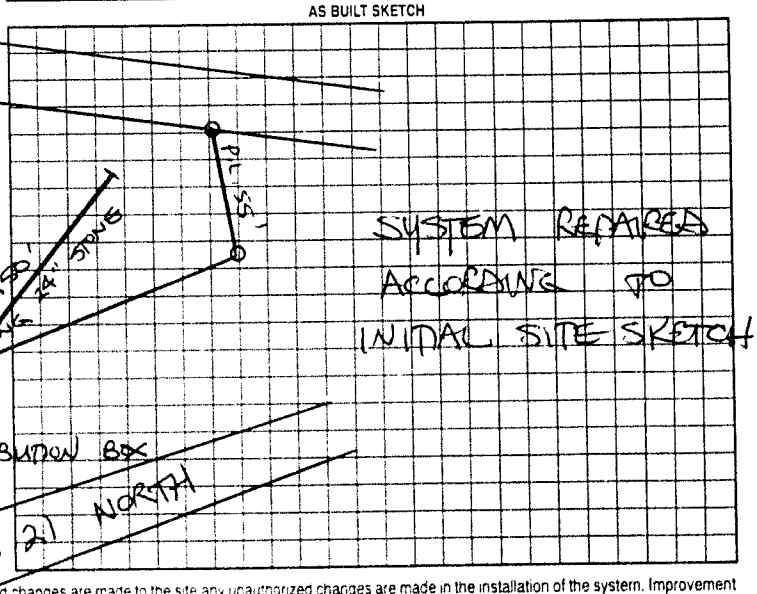

Permit can be suspended or revoked if any false information is supplied toward securing the permit, any unauthorized changes are made to the site, any unauthorized changes are made in the installation of the system. Improvement Permit with plat valid without expiration. Improvement Permit with site plan valid for sixty months. Authorization to Construct is valid for a period equal to that of Improvement Permit – not to exceed sixty months.

Signed: Deborah B Cooper date 9-4-01

Improvement Permit by: STEVE HEDRICK date 9-4-01

Authorization to Construct by: STEVE HEDRICK date 9-4-01

Installed by: TOMMY NIXON

Operation Permit by STEVE HEDRICK date 9-13-01

Existing System Inspection by date

HEALTH DEPT COPY WHITE OWNER COPY (FINAL) YELLOW OWNER COPY (INITIAL) PINK