IREDELL COUNTY HEALTH DEPARTMENT

STATESVILLE 704-878-5305 MOORESVILLE 704-664-5281

IMPROVEMENT PERMIT / AUTHORIZATION TO CONSTRUCT / OPERATION PERMIT / EXISTING SYSTEM INSPECTION

PERMIT# 78084 PIN# 4747908721 DATE 11-19-98

OWNER OR CONTRACTOR Ebenezer School PHONE: Business 876 4145 Home

ADDRESS 134 Ebenezer Ln Statesville, N.C.

LOCATION 21 N on left past I-77

SUBDIVISION BLOCK / SECTION LOT LOT AREA 12.9 acres SITE CLASS. P5 DESIGN FLOW 3750 gpd L.T.A.R.

Septic Tank: 4000 Gallons; STB Date

Pump Tank: Gallons; PT Date

Pump Make: Model Serial No.

Nitrification Field: No Fields 2 Square Feet 7560 Linear Feet 2520

No Lines 24 Trench Width 36" Max Trench Bottom Depth 36" Gravel Depth 12"

☐ New System ☐ Repair System Type: I, II, III, IV, V, VI

System Description:

Repair System Description:

Maintenance Agreement Required: ☐ Yes ☐ No

☐ House/Mod. Home No. Bedrooms

☐ Mobile Home No. Bathrooms

☐ Business No. Employees

☐ Other


☐ Slab ☐ Crawl Space ☐ Basement w/plumbing ☐ Basement wo/plumbing

Water Supply: ☐ Individual ☑ Public ☐ Community

Comments:/Conditions: Proposed Dev. Classroom 25 Students

Comments:/Conditions: Adding mobile Class Room occupancy & Rate 25 people Present Enrollment 272 for Total 297

INITIAL SITE SKETCH

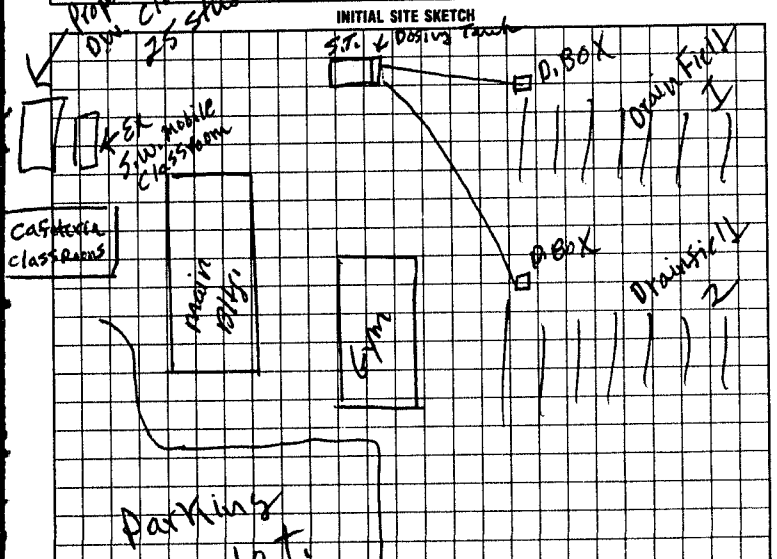

AS BUILT SKETCH

297 X 12 gal/person = 3564 gallons/day which is under Design Flows

I understand that this permit can be suspended or revoked if any false information is supplied toward securing the permit/any unauthorized changes are made to the site/any unauthorized changes are made in the installation of the system. Improvement Permit with plat valid without expiration. Improvement Permit with site plan valid for sixty months. Authorization to Construct is valid for a period equal to that of Improvement Permit – not to exceed sixty months.

Signed: date

Improvement Permit by: date

Authorization to Construct by: date

Installed by:

Operation Permit by: date

Existing System Inspection by: P. C. Moore date 11-19-98

HEALTH DEPT. COPY: WHITE INSPECTION COPY (FINAL): GREEN OWNER COPY (FINAL): YELLOW INSPECTION COPY (INITIAL): PINK OWNER COPY (INITIAL): GOLD