IREDELL COUNTY HEALTH DEPARTMENT

Statesville Phone TR 3-7271 Mooresville Phone NO 3-1271

PERMIT TO INSTALL SEPTIC TANK

Permit NO. _____ Permit Date Aug. 22 1957

Owner Zeb Deimsters Address Jennings Rd. city

Installed By C. Hake Address Rte. 7 Box 312 city

Location of Property [redacted] on Right on Jennings

Rd.


Tank		Capacity		Length of Lines		Fixtures	
Block	( )	800	(✓)	150'	( )	No. of Baths	( )
Precast	(✓)	900	( )	175'	( )	Dishwasher	( )
		1000	( )	200'	( )	Garbage Grdr.	( )
		1100	( )	225'	( )	Auto-Washer	( )
		1200	( )	250'	( )	Other	
		Other		Other	50 ft. sink drain		

NOTIFY HEALTH DEPARTMENT AT LEAST EIGHT HOURS BEFORE TANK IS TO BE INSPECTED.

Final Inspection 8-22-1957 Approved ( ) Disapproved ( )

Remarks 50 ft sink drain

Covered

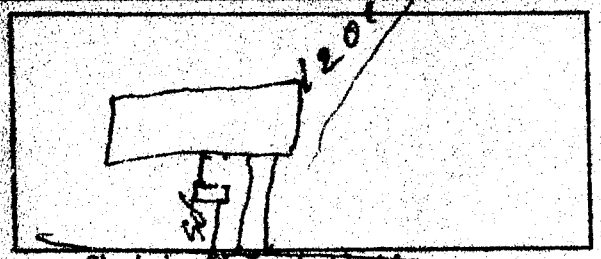

Sketch of Installation

R. A.

Sanitarian