IREDELL COUNTY HEALTH DEPARTMENT

STATESVILLE 704-878-5305 MOORESVILLE 704-664-5281

IMPROVEMENT PERMIT / CERTIFICATE OF COMPLETION / OPERATION PERMIT / EXISTING SYSTEM INSPECTION

PROPERTY DESCRIPTION NO. Repair DATE 4-23-97 TAX MAP NO. Repair Watershed: ☐ Yes ☐ No

OWNER OR CONTRACTOR John Fox PHONE: Business Home 704 455 2435

ADDRESS 311 Plaza Drive Harrisburgh NC

LOCATION 21 N TL Jennings TR Fox Park Ln First 2 m/H on (L)

SUBDIVISION BLOCK / SECTION LOT LOT AREA SITE CLASS. DESIGN FLOW 480 L.T.A.R. .03

Septic Tank: 1000 Gallons; STB Date

Pump Tank: Ex. Frig Gallons; PT Date

Pump Make: Model Serial No.

Nitrification Field: No Fields 2 Square Feet Linear Feet I

No Lines 9 Trench Width 36in Max Trench Bottom Depth 36in Gravel Depth Sand

☐ New System ☒ Repair System Type: I, II, (III) IV, V, VI

System Description:

Repair System Description: Chambers

Maintenance Agreement Required: ☐ Yes ☐ No

☐ House/Mod. Home No. Bedrooms 4

☒ Mobile Home No. Bathrooms 2

☐ Business No. Employees

☐ Other 2 Mobile / 1 System


☐ Slab ☒ Crawl Space ☐ Basement w/plumbing ☐ Basement wo/plumbing

Water Supply: ☐ Individual ☐ Community ☐ Public


Comments: keep lines on contour 9ft on center
Split washer box to upper lines, septic lines
below washer box
* must move water line keep 10 ft from system

Comments: 300 linear feet for septic
100 linear ft for washer
Check sanitary T's replace if needed

INITIAL SITE SKETCH

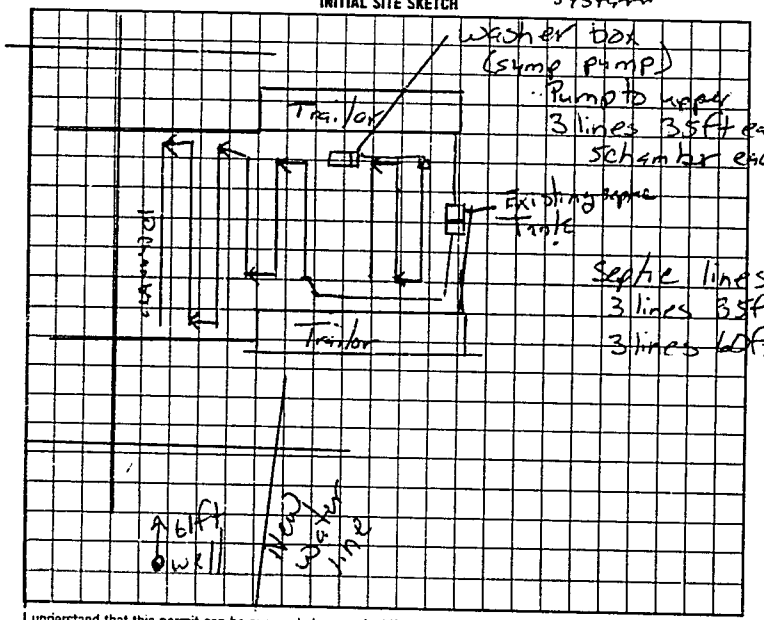

AS BUILT SKETCH

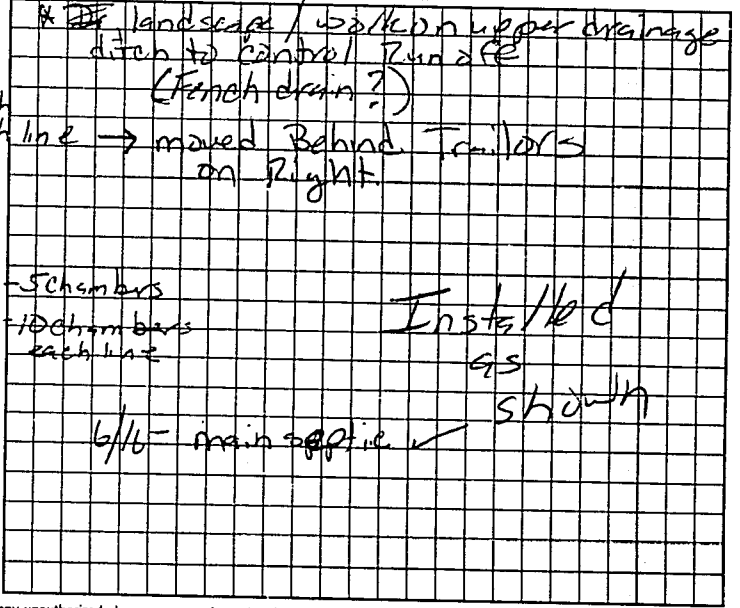

I understand that this permit can be suspended or revoked if any false information is supplied toward securing the permit/any unauthorized changes are made to the site/any unauthorized changes are made in the installation of the system. Improvement Permit is valid for 60 months from date of issuance.

Signed: John Fox

Improvement Permit by: Mark Cutts date 4-23-97

~~Existing System Inspection by:~~ Author, Eaton to Const. Mark Cutts date 4-23-97

Installed by: Hally Reep / Tommy Frye

Certificate of Completion by: date

Operation Permit by: Mark Cutts date 6-18-97

HEALTH DEPT. COPY: WHITE INSPECTION COPY (FINAL): GREEN OWNER COPY (FINAL): YELLOW INSPECTION COPY (INITIAL): PINK OWNER COPY (INITIAL): GOLD

26500