48166

IREDELL COUNTY HEALTH DEPARTMENT

STATESVILLE 704-878-5305 MOORESVILLE 704-664-5281

IMPROVEMENT PERMIT / CERTIFICATE OF COMPLETION / OPERATION PERMIT / EXISTING SYSTEM INSPECTION

PROPERTY DESCRIPTION NO. 16585 DATE 7-1-93 TAX MAP NO. pt 106-2-A-34

OWNER OR CONTRACTOR David R Peoples PHONE: Business Home 632-7144

ADDRESS R+S Box 54 Taylorsville N.C.

LOCATION 21N TL Jennings Rd T/2 mi on Rt behind Roy Hobbs House

SUBDIVISION BLOCK SECTION LOT LOT AREA 100'X200 SITE CLASS. P.S. L.T.A.R. .4

Water Supply: ☐ Individual ☐ Community ☑ Public

Septic Tank: 1000 Gallons; STB 1012 Date 4/20/93

Pump Tank: Gallons; PT Date

Nitrification Field: No Fields 1 Square Feet 900 Linear Feet 300

No Lines 3 Trench Width 36 Trench Depth 24 Gravel Depth 12

☑ New System ☐ Repair System Type: I, II, III, IV, V, VI

System Description: Conv. Gravity

Repair System Description: " "

Maintenance Agreement Required: ☐ Yes ☑ No

☐ House/Mod. Home ☑ Mobile Home ☐ Business ☐ Other

No. Bedrooms 3 No. Bathrooms 2 No. Employees

☐ Slab ☑ Crawl Space ☐ Basement w/plumbing ☐ Basement wo/plumbing

Garbage Disposal: ☐ Yes ☑ No


Auto. Dishwasher: ☐ Yes ☑ No

Auto. Washing Machine: ☑ Yes ☐ No


Other

Comments ② LINES CHANGED TO CONTOUR ② BEHIND 3RD ⓗ ON Ⓡ PAST FOX LANE

INITIAL SITE SKETCH

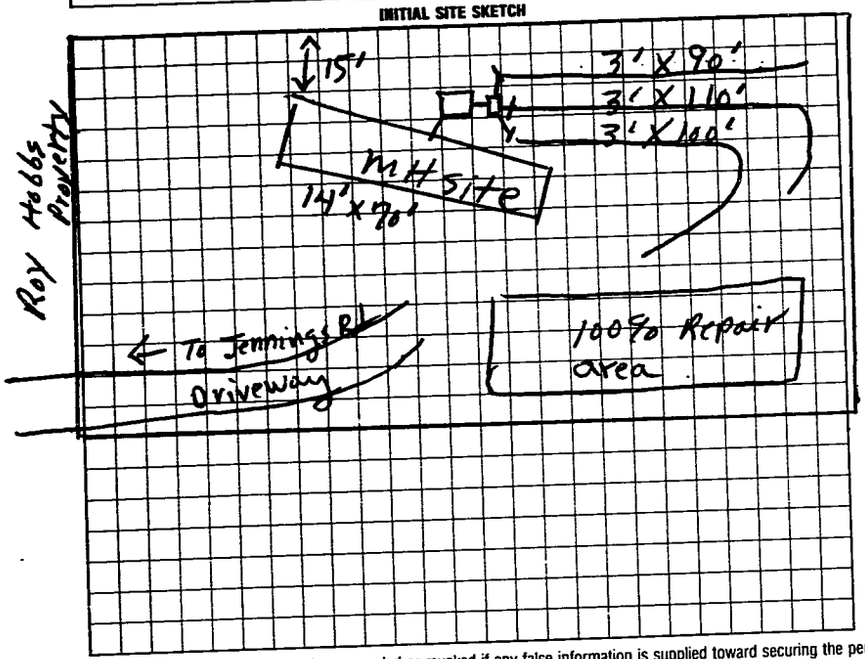

AS BUILT SKETCH

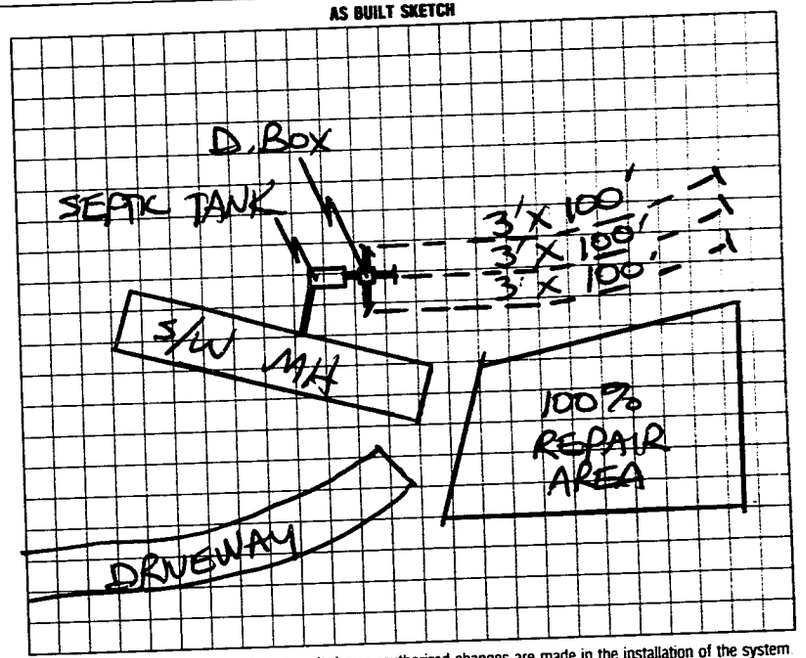

I understand that this permit can be suspended or revoked if any false information is supplied toward securing the permit/any unauthorized changes are made to the site/any unauthorized changes are made in the installation of the system. Improvement Permit is valid for 60 months from date of issuance.

Signed: X David R Peoples

Improvement Permit by: J. C. Moore date 7-1-93

Existing System Inspection by: date

Installed by: Tommy Cothren / Steve Hedrick date 7/27/93

Certificate of Completion by: date

Operation Permit by: date

HEALTH DEPT. COPY: WHITE INSPECTION COPY (FINAL): GREEN OWNER COPY (FINAL): YELLOW INSPECTION COPY (INITIAL): PINK OWNER COPY (INITIAL): GOLD