IREDELL COUNTY HEALTH DEPARTMENT - *ENVIRONMENTAL HEALTH* ☐ STATESVILLE OFFICE 704-878-5305 ☐ MOORESVILLE OFFICE 704-664-5281

IMPROVEMENT PERMIT / AUTHORIZATION TO CONSTRUCT @ / **OPERATION PERMIT** @ **EXISTING SYSTEM INSPECTION**

PERMIT # 168433 PIN # 4747-95-0112 DATE OCTOBER 11, 2011

OWNER KORAL BLOCH APPLICANT: SAME PHONE: Home/Cell # 704-397-7443 Business # 727-642-0139

SITE ADDRESS 362 JENNINGS RD, STVL, 28625-9487 OWNER / APPLICANT ADDRESS SAME

SITE DIRECTIONS US 21 NORTH, TL JENNINGS RD, SITE ON RIGHT AT BOX #362

SUBDIVISION _____ BLOCK / SECTION _____ LOT # _____ LOT AREA ~1 ACRE DESIGN FLOW 360 L.T.A.R. 0.30 GPD/FT

Septic Tank EXISTING Gallons: STB _____ Date _____

Pump Tank _____ Gallons: P T _____ Date _____

Pump Make _____ Model _____ Serial # _____

No. Nitrification Fields: 1 No. Lines 1 Linear Feet 100'

Trench Width 36" Max. Trench Bottom Depth 34"

☐ ~~Repair~~ ☑ Expansion System Type I II (III) IV V VI

System Description: 25% REDUCTION GRAVITY

Repair System Description: 25% REDUCTION

Maintenance Agreement Required ☐ YES ☑ NO

~~Gravel Depth~~ N/A ☑ GRAVITY ☐ PRESSURE

☑ Residence No. Bedrooms 3

☐ Business No. Persons _____

☐ Other No. Employees _____


☐ Slab ☐ Crawl Space

☐ Basement w/plumbing ☐ Basement w/o plumbing

Water Supply: ☐ Private ☑ Public ☐ Community

Comments / Conditions ① INSTALL NEW DROP BOX AT DISTAL END OF EXISTING BED, SERIALLY FEEDING NEW 3' X 100' 25% REDUCTION DRAINLINE. ② KEEP MINIMUM 10' FROM PROPERTY LINE, 15' FROM EMBANKMENT

INITIAL SITE SKETCH

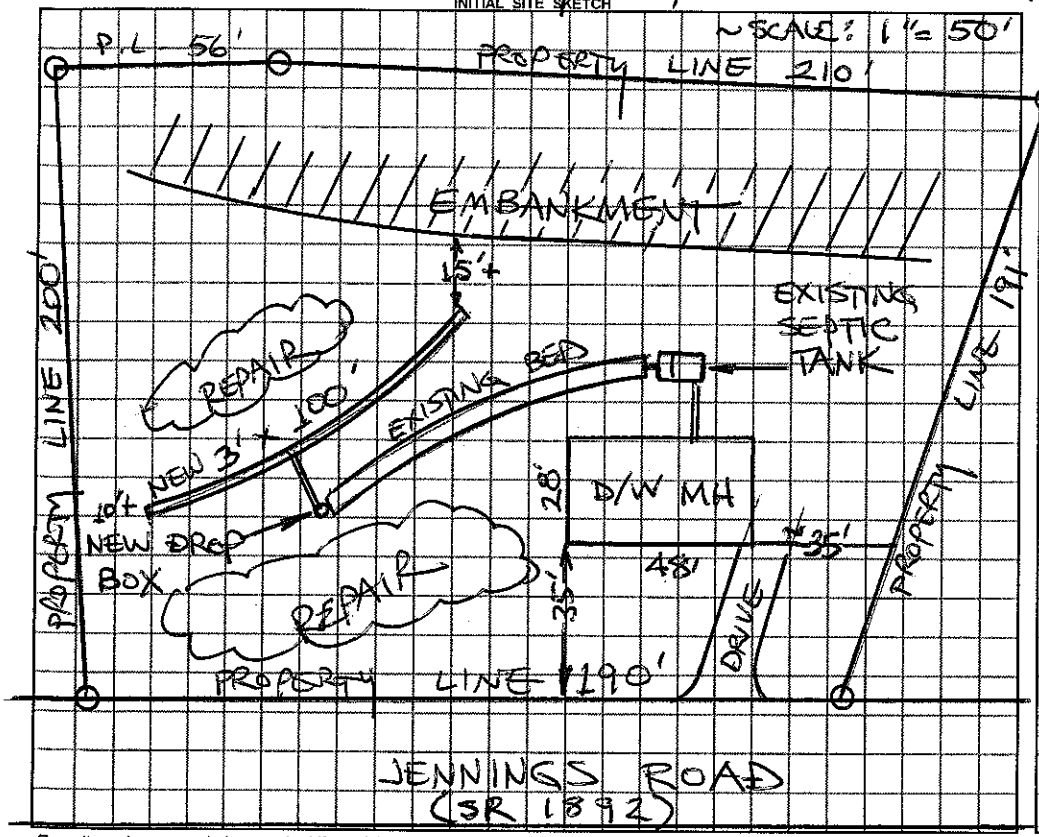

AS BUILT SKETCH

Permit can be suspended or revoked if any false information is supplied toward securing the permit / any unauthorized changes are made to the site / any unauthorized changes are made in the installation of the system.

☐ ***IMPROVEMENT PERMIT*** with plat valid without expiration. ☑ ***IMPROVEMENT PERMIT*** with ~~plat valid without expiration.~~ site plan valid 60 mo. ☑ ***AUTHORIZATION TO CONSTRUCT*** valid for period equal to IMPROVEMENT PERMIT--not to exceed 60 mo.

Owner / Applicant Signature: _____ Date 10/13/11 Installed by: Tommy Frye

IMPROVEMENT PERMIT by: STEVE HEDRICK REHS Date 10-11-2011 OPERATION PERMIT by: _____ REHS Date 11-3-11

AUTHORIZATION TO CONSTRUCT by: STEVE HEDRICK REHS Date 10-11-2011 Existing System Inspected by: _____ REHS Date _____

YOU SHOULD CONTACT A LOCATOR SERVICE PRIOR TO ANY EXCAVATION

White Copy – Environmental Health YELLOW COPY (Final) Owner / Applicant PINK COPY (Initial) Owner / Applicant