48543

IREDELL COUNTY HEALTH DEPARTMENT

STATESVILLE 704-878-5305 MOORESVILLE 704-664-5281

IMPROVEMENT PERMIT / CERTIFICATE OF COMPLETION / OPERATION PERMIT / EXISTING SYSTEM INSPECTION

PROPERTY DESCRIPTION NO. 16295 DATE 4-25-93 TAX MAP NO. 10A-A-42

OWNER OR CONTRACTOR Marty + Wanda Blevins PHONE: Business Home 876-0617

ADDRESS R+4 Box 353 Statesville

LOCATION 21N TL Jennings Rd SR Reeves Rd 1/4 mi on left

SUBDIVISION BLOCK / SECTION LOT 1.044 LOT AREA .28 SITE CLASS. L.T.A.R.

Water Supply: ☐ Individual ☐ Community ☑ Public

Septic Tank: 1000 Gallons: STB 358 Date 6-19-93

Pump Tank: Gallons: PT Date

Nitrification Field: No Fields 1 Square Feet 900 Linear Feet 300

No. Lines 3 Trench Width 36 Trench Depth 18-24 Gravel Depth 12

☑ New System ☐ Repair System Type: I (II) III, IV, V, VI

System Description: Conv. Gravity

Repair System Description: " "

Maintenance Agreement Required: ☐ Yes ☑ No

☑ House/Mod. Home ☐ Mobile Home ☐ Business ☐ Other

No. Bedrooms 2 No. Bathrooms 2 No. Employees

☐ Slab ☑ Crawl Space ☐ Basement w/plumbing ☐ Basement wo/plumbing

Garbage Disposal: ☐ Yes ☑ No


Auto. Dishwasher: ☐ Yes ☑ No

Auto. Washing Machine: ☐ Yes ☐ No

Other

Comments

INITIAL SITE SKETCH

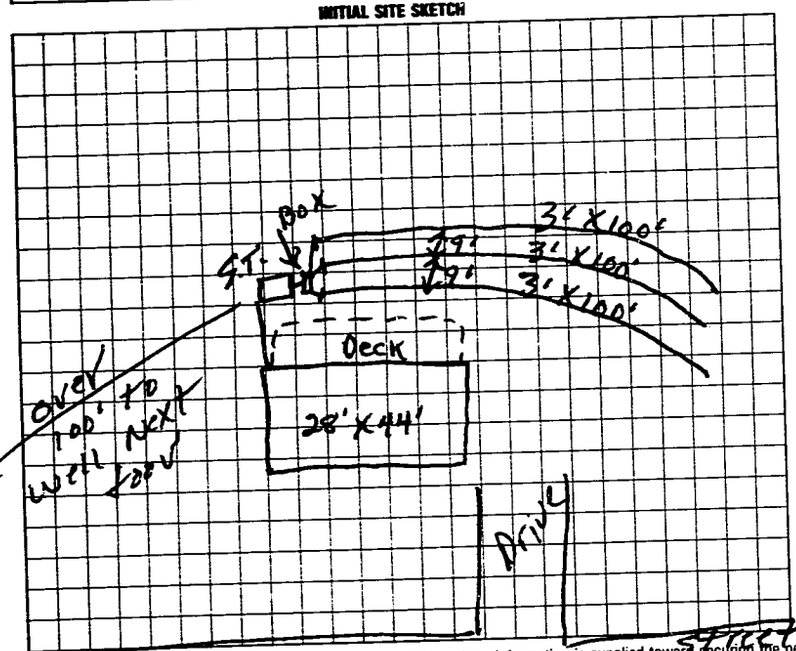

AS BUILT SKETCH

SYSTEM INSTALLED DURING PERIOD OF RAIN WHICH MAY AFFECT SYSTEM LIFESPAN. DRAINLINES INSTALLED OUT OF GRADE & MAY FAIL PREMATURELY AT LINE ENDS.

I understand that this permit can be suspended or revoked if any false information is supplied toward securing the permit/any unauthorized changes are made to the site/any unauthorized changes are made in the installation of the system. Improvement Permit is valid for 60 months from date of issuance.

Signed: Otis W Kelly

Improvement Permit by: E.C. Moore date 8-25-93

Existing System Inspection by: date

Installed by: Tommy Frye Steve Hedrick date 9/8/93

Certificate of Completion by: date

Operation Permit by: date

HEALTH DEPT. COPY: WHITE INSPECTION COPY (FINAL): GREEN OWNER COPY (FINAL): YELLOW INSPECTION COPY (INITIAL): PINK OWNER COPY (INITIAL): GOLD