IREDELL COUNTY HEALTH DEPARTMENT

STATESVILLE 704-878-5305 MOORESVILLE 704-664-5281

48496

IMPROVEMENT PERMIT / CERTIFICATE OF COMPLETION / OPERATION PERMIT / EXISTING SYSTEM INSPECTION

PROPERTY DESCRIPTION NO. 16672 DATE 7-20-93

OWNER OR CONTRACTOR Rick Dyson PHONE: Business 528 4664 Home

ADDRESS Box 1174 Statesville TAX MAP NO. 104-1-A-5

LOCATION 21 N to Rt 10 Jennings to Brewer to Millstone 5th lot on left

SUBDIVISION Amberside BLOCK / SECTION LOT 5 LOT AREA .764 SITE CLASS. PS L.T.A.R. .4

Water Supply: ☐ Individual ☐ Community ☒ Public

Septic Tank: 1000 Gallons; STB 794 Date 8-10-93

Pump Tank: Gallons; PT Date

Nitrification Field: No Fields 1 Square Feet 900 Linear Feet 300

No Lines 3 Trench Width 36 Trench Depth 18+36 Gravel Depth 12

☐ New System ☐ Repair System Type: I (II.) IV. V. VI

System Description: Conventional

Repair System Description: #2 11

Maintenance Agreement Required: ☐ Yes ☒ No

☐ House/Mod. Home No. Bedrooms 3

☐ Mobile Home No. Bathrooms 2

☐ Business No. Employees

☐ Other

☐ Slab ☒ Crawl Space ☐ Basement w/plumbing ☐ Basement wo/plumbing

Garbage Disposal: ☐ Yes ☒ No


Auto. Dishwasher: ☐ Yes ☐ No

Auto. Washing Machine: ☒ Yes ☐ No


Other

Comments

INITIAL SITE SKETCH

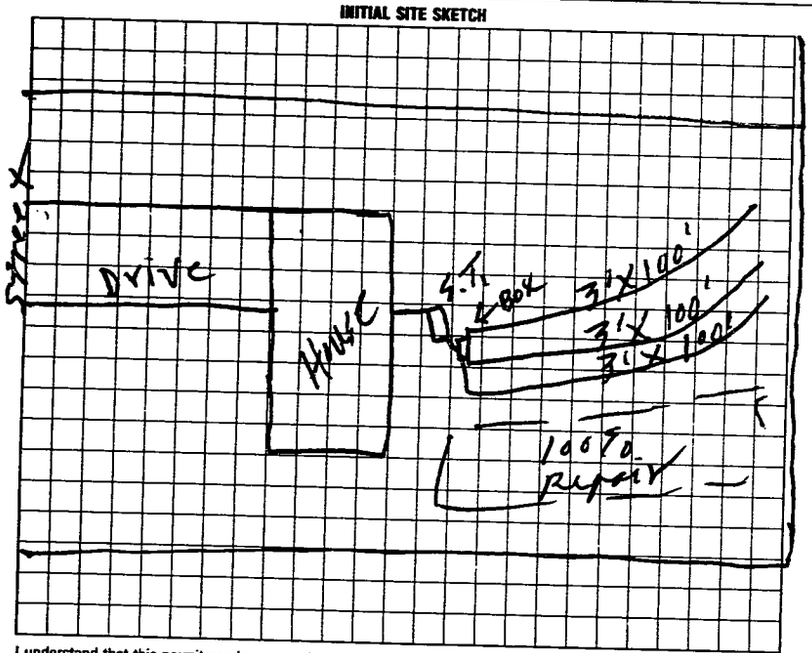

AS BUILT SKETCH

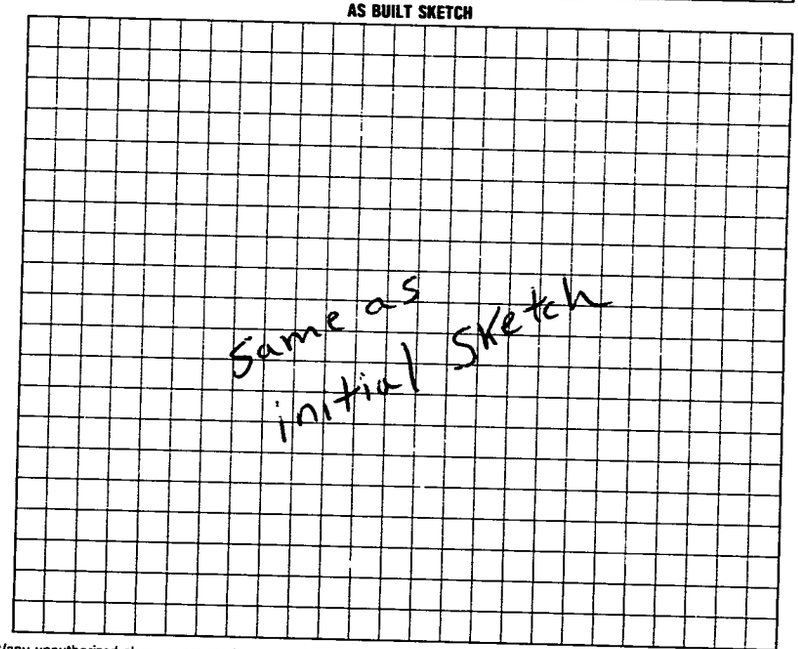

I understand that this permit can be suspended or revoked if any false information is supplied toward securing the permit/any unauthorized changes are made to the site/any unauthorized changes are made in the installation of the system. Improvement Permit is valid for 60 months from date of issuance.

Signed:

Improvement Permit by: L. E. Moore date 7-26-93

Existing System Inspection by: date

Installed by: Wes Lyhorn

Certificate of Completion by: L. E. Moore date 10-8-93

Operation Permit by: date

HEALTH DEPT. COPY: WHITE INSPECTION COPY (FINAL): GREEN OWNER COPY (FINAL): YELLOW INSPECTION COPY (INITIAL): PINK OWNER COPY (INITIAL): GOLD