IREDELL COUNTY HEALTH DEPARTMENT

STATESVILLE 704-878-5305 MOORESVILLE 704-664-5281

IMPROVEMENT PERMIT / CERTIFICATE OF COMPLETION / OPERATION PERMIT / EXISTING SYSTEM INSPECTION

PROPERTY DESCRIPTION NO. 67506 DATE 6-26-97 TAX MAP NO. 4747 97 8441 Watershed: ☐ Yes ☑ No

OWNER OR CONTRACTOR Michael J. Weston PHONE: Business Home 704 876 4435

ADDRESS 203 Reeves Rd

LOCATION 21N TL Jennings TR Reeves TL millstone 1st DR. RT.

SUBDIVISION BLOCK / SECTION LOT LOT AREA 15,000 Sq' SITE CLASS. PS DESIGN FLOW 360 L.T.A.R. .3

Septic Tank: 1000 Gallons; STB Date 5-27-97

Pump Tank: Gallons; PT Date

Pump Make: Model Serial No.

Nitrification Field: No Fields 1 Square Feet 900 Linear Feet 300

No Lines 5 Trench Width 36" Max Trench Bottom Depth 36" Gravel Depth N/A

☑ New System ☐ Repair System Type: I, II, III, IV, V, VI

System Description: Gravity chambers

Repair System Description: Pump To Panels

Maintenance Agreement Required: ☐ Yes ☑ No

☐ House/Mod. Home ☑ Mobile Home ☐ Business ☐ Other

No. Bedrooms 3 No. Bathrooms 2 No. Employees


☐ Slab ☑ Crawl Space ☐ Basement w/plumbing ☐ Basement wo/plumbing

Water Supply: ☐ Individual ☐ Community ☑ Public


Comments:

Comments:

INITIAL SITE SKETCH

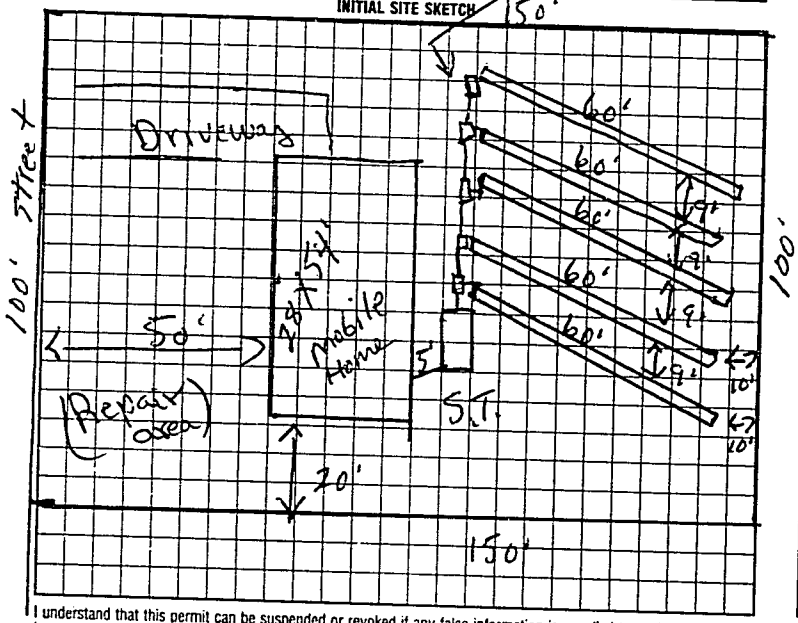

AS BUILT SKETCH

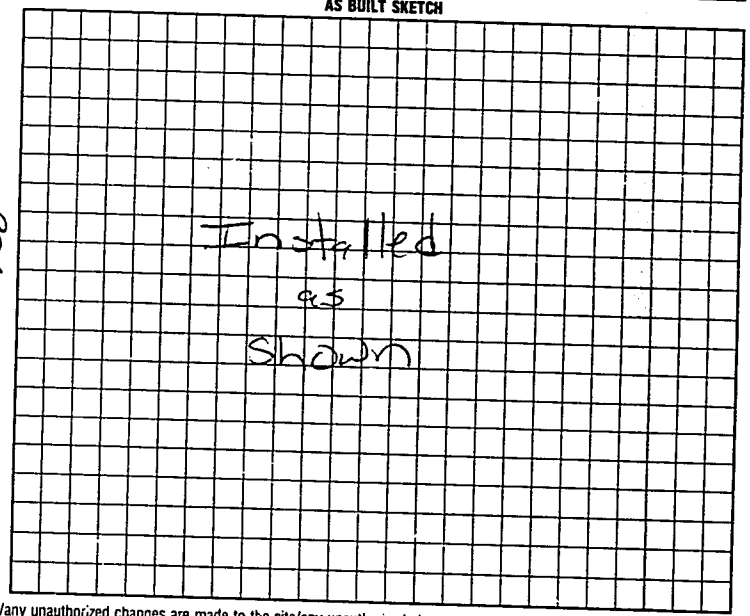

I understand that this permit can be suspended or revoked if any false information is supplied toward securing the permit/any unauthorized changes are made to the site/any unauthorized changes are made in the installation of the system. Improvement Permit is valid for 60 months from date of issuance.

Signed: Michael J. Weston

Improvement Permit by: P.C. Moore date 6-26-97

Existing System Inspection by: P.C. Moore date 6-26-97

Authorization to count.

Installed by: Andy Daniels

Certificate of Completion by: date

Operation Permit by: Mark C. Outlaw date 7-9-97

HEALTH DEPT. COPY: WHITE INSPECTION COPY (FINAL): GREEN OWNER COPY (FINAL): YELLOW INSPECTION COPY (INITIAL): PINK OWNER COPY (INITIAL): GOLD

Authorization to count Expires 60 mos from issue