IREDELL COUNTY HEALTH DEPARTMENT

STATESVILLE 704-878-5305 MOORESVILLE 704-664-5281

IMPROVEMENT PERMIT / AUTHORIZATION TO CONSTRUCT / OPERATION PERMIT / EXISTING SYSTEM INSPECTION

PERMIT# B3462 PIN# 4779978574 DATE 1-23-06

OWNER OR CONTRACTOR Corey Weston PHONE: Business _____ Home 704-622-6525

ADDRESS 115 Millstone Dr Statesville NC 28677

LOCATION 210 Jennings RD (R) Reeves RD (L) Millstone (R) Approximately 1/2 mile

SUBDIVISION _____ BLOCK / SECTION _____ LOT _____ LOT AREA 1.53 SITE CLASS. V DESIGN FLOW 360 L.T.A.R. .3

Septic Tank: 1000 Gallons; STB 328 Date 11-2005 ☐ New System ☐ Repair System Type: I, II, III, IV, V, VI ☐ House/Mod. Home No. Bedrooms 3

Pump Tank: _____ Gallons; PT _____ Date _____ System Description: 2570 GRAVITY ☐ Mobile Home No. Bathrooms _____

Pump Make: _____ Model _____ Serial No. _____ Repair System Description: LRP ☐ Business No. Employees _____

Nitrification Field: No Fields _____ Square Feet 1200 Linear Feet 300 Maintenance Agreement Required: ☐ Yes ☐ No ☐ Other _____


No Lines 4 Trench Width 36" Max Trench Bottom Depth 36" Gravel Depth NA ☐ Slab ☐ Crawl Space ☐ Basement w/plumbing ☐ Basement wo/plumbing

Water Supply: ☐ Individual ☑ Public ☐ Community

Comments:/Conditions: Maintain all set Backs
Install on Contour

Comments:/Conditions:
Quick & Compact
Blue top Lite Jetter

INITIAL SITE SKETCH

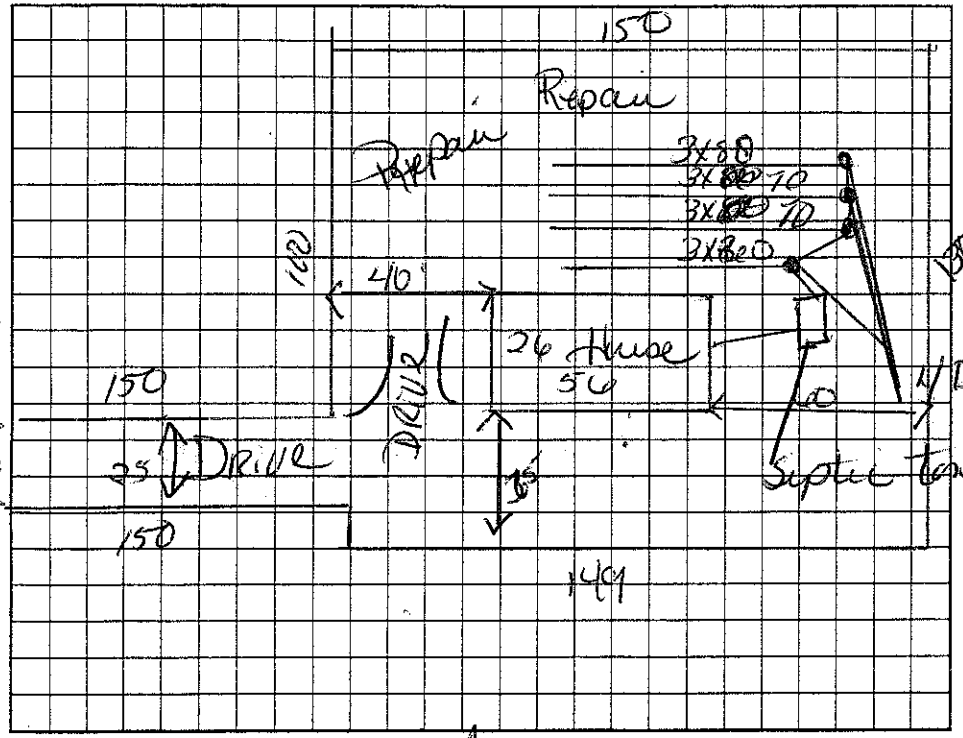

AS BUILT SKETCH

Permit can be suspended or revoked if any false information is supplied toward securing the permit/any unauthorized changes are made to the site/any unauthorized changes are made in the installation of the system. Improvement Permit with plat valid without expiration. Improvement Permit with site plan valid for sixty months. Authorization to Construct is valid for a period equal to that of Improvement Permit – not to exceed sixty months.

Signed: _____ date _____ Installed by: HNDY DAVIS

Improvement Permit by: _____ date 2-2-06 Operation Permit by: _____ date 2-2-06

Authorization to Construct by: _____ date 2-2-06 Existing System Inspection by: _____ date _____

HEALTH DEPT. COPY: WHITE OWNER COPY (FINAL): YELLOW OWNER COPY (INITIAL): PINK

Install Star