IREDELL COUNTY HEALTH DEPARTMENT

STATESVILLE 704-878-5305 MOORESVILLE 704-664-5281

IMPROVEMENT PERMIT / AUTHORIZATION TO CONSTRUCT / OPERATION PERMIT / EXISTING SYSTEM INSPECTION

PERMIT# 92775 PIN# 4747 97 8655 DATE

OWNER OR CONTRACTOR Coral Scott PHONE: Business Home 924-8878

ADDRESS 818 Phillips Ln. Statesville NC 28625

LOCATION 21N, L Jennings, R Reeves, L Millstone, on RT

SUBDIVISION Ambleside BLOCK / SECTION — LOT 32 LOT AREA .78 SITE CLASS PS DESIGN FLOW 480 L.T.A.R. 0.3

Septic Tank: 1000 Gallons; STB 1012 Date 10-8-2000 ☒ New System ☐ Repair System Type: I, (II), III, IV, V, VI ☒ House/Mod. Home No. Bedrooms 4

Pump Tank: Gallons; PT Date System Description: Gravity Conventional ☐ Mobile Home No. Bathrooms 2.5

Pump Make: Model Serial No. Repair System Description: Gravity / Pump PP85 ☐ Business No. Employees

Nitrification Field: No Fields 1 Square Feet 1600 Linear Feet 535 Maintenance Agreement Required: ☐ Yes ☒ No ☐ Other

No Lines 5 @ 107' Trench Width 36" Max Trench Bottom Depth 36" Gravel Depth 12" ☐ Slab ☒ Crawl Space ☐ Basement w/plumbing ☐ Basement wo/plumbing

Water Supply: ☐ Individual ☒ Public ☐ Community


Comments:/Conditions:

Comments./Conditions:

Septic Tank Risers Installed

- Polylok Filter Installed

INITIAL SITE SKETCH

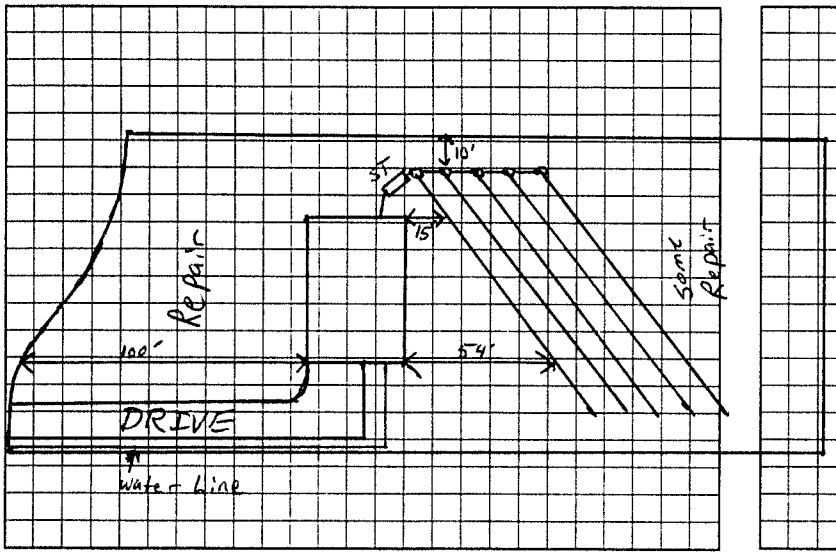

AS BUILT SKETCH

Installed as Shown on Initial Site Sketch

Permit can be suspended or revoked if any false information is supplied toward securing the permit/any unauthorized changes are made to the site/any unauthorized changes are made in the installation of the system. Improvement Permit with plat valid without expiration. Improvement Permit with site plan valid for sixty months. Authorization to Construct is valid for a period equal to that of Improvement Permit – not to exceed sixty months.

Signed: Coral Scott date 11-9-00 Installed by: David Yount

Improvement Permit by: RSE date 11/8/00 Operation Permit by: William A Johnson RSI date 4/19/01

Authorization to Construct by: RSE date 11/8/00 Existing System Inspection by: date

HEALTH DEPT COPY WHITE OWNER COPY (FINAL): YELLOW OWNER COPY (INITIAL): PINK