430

IREDELL COUNTY HEALTH DEPARTMENT

STATESVILLE 704-878-5305 MOORESVILLE 704-664-5281

IMPROVEMENT PERMIT / AUTHORIZATION TO CONSTRUCT / OPERATION PERMIT / EXISTING SYSTEM INSPECTION

PERMIT# 76694 PIN# 4747 98 6253 DATE 10-31-98

OWNER OR CONTRACTOR James Wooten PHONE: Business 873 2890 Home

ADDRESS 217 E. Meadowview Dr. Sta

LOCATION (151 millstone)

SUBDIVISION Ambleside BLOCK / SECTION LOT 8 LOT AREA 110'X235' SITE CLASS PS DESIGN FLOW 360 L.T.A.R. .3

Septic Tank: 1000 Gallons; STB 1007 Date 3/31/00
Pump Tank: Gallons; PT Date
Pump Make: Model Serial No.
Nitrification Field: No Fields 1 Square Feet 1200 Linear Feet 400
No Lines 4 Trench Width 36" Max Trench Bottom Depth 36" Gravel Depth 12"

☑ New System ☐ Repair System Type: I ☐ II, III, IV, V, VI
System Description: Conv. Gravity
Repair System Description: Gravity 3526/Rd
Maintenance Agreement Required: Yes No

☑ House/Mod. Home ☐ Mobile Home ☐ Business ☐ Other
No. Bedrooms 3 No. Bathrooms 2 No. Employees


Water Supply: ☐ Individual ☑ Public ☐ Community

Slab ☑ Crawl Space ☐ Basement w/plumbing ☐ Basement wo/plumbing

Comments/Conditions: 1) 143 ft
114 ft
114 ft E

Comments/Conditions: 2) B 111
M 102, 112
E 112
3) B 113
M 112 3
E 114
B 117
M 117 1
E 119 2

INITIAL SITE SKETCH

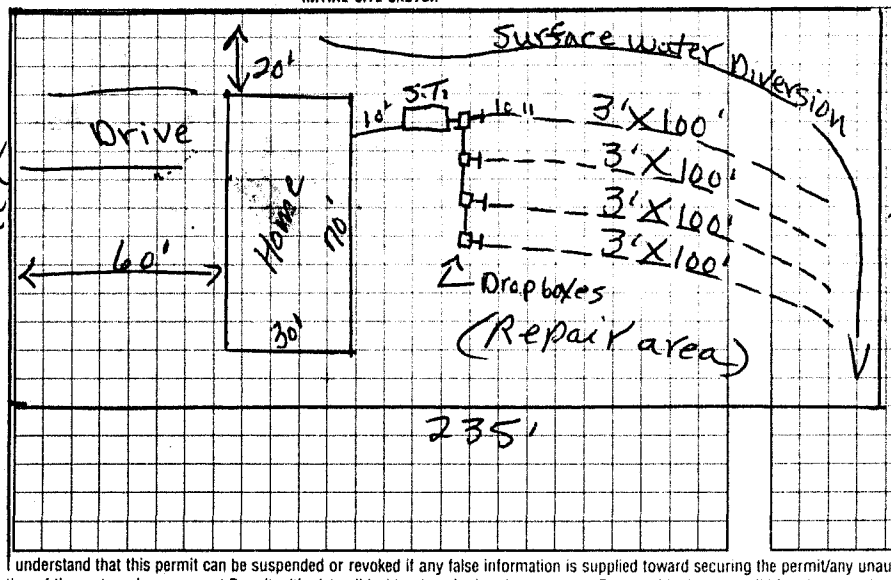

AS BUILT SKETCH

I understand that this permit can be suspended or revoked if any false information is supplied toward securing the permit/any unauthorized changes are made to the site/any unauthorized changes are made in the installation of the system. Improvement Permit with plat valid without expiration. Improvement Permit with site plan valid for sixty months. Authorization to Construct is valid for a period equal to that of Improvement Permit – not to exceed sixty months.

Signed: [signature] date 11-2-98 Installed by: TRAVIS Enterprises

Improvement Permit by: R.C. Moore date 10-31-98 Operation Permit by: C. B[illegible] date 10/13/00

Authorization to Construct by: R.C. Moore date 10-31-98 Existing System Inspection by: date

HEALTH DEPT. COPY: WHITE INSPECTION COPY (FINAL): GREEN OWNER COPY (FINAL): YELLOW INSPECTION COPY (INITIAL): PINK OWNER COPY (INITIAL): GOLD