I . COUNTY HEALTH DEPARTMENT

STATESVILLE 704-878-5305 MOORESVILLE 704-664-5281

IMPROVEMENT PERMIT / AUTHORIZATION TO CONSTRUCT / OPERATION PERMIT / EXISTING SYSTEM INSPECTION

PERMIT# 76693 PIN# 4747 98 6354 DATE 10-31-98

OWNER OR CONTRACTOR James wooten PHONE: Business 873-1890 Home

ADDRESS 217 East meadowview Dr. Sta NuC.

LOCATION 159 millstone Dr. Jennings TR Reeves TL millstone 1/10 mi left

SUBDIVISION Ambleside BLOCK / SECTION LOT 9+10 LOT AREA 220' X 235 SITE CLASS PS DESIGN FLOW 360 L.T.A.R. .3

Septic Tank: 1000 Gallons; STB 1007 Date 3 17 00
Pump Tank: Gallons; PT Date
Pump Make: Model Serial No.
Nitrification Field: No Fields 1 Square Feet 1200 Linear Feet 400
No Lines 3 Trench Width 36" Max Trench Bottom Depth 24" Gravel Depth 12"

☑ New System ☐ Repair System Type: I ☑ II III IV V VI
System Description: Conv. Gravity "
Repair System Description:
Maintenance Agreement Required ☐ Yes ☑ No
☐ Slab ☐ Crawl Space ☑ Basement w/plumbing ☐ Basement wo/plumbing


☑ House/Mod. Home No. Bedrooms 3
☐ Mobile Home No. Bathrooms 3
☐ Business No. Employees
☐ Other

Water Supply: ☐ Individual ☑ Public ☐ Community


Comments/Conditions:

Comments/Conditions: Installed deeper than 24" due to basement plumbing under slab set septic tank deep. ZAbel Filter

INITIAL SITE SKETCH

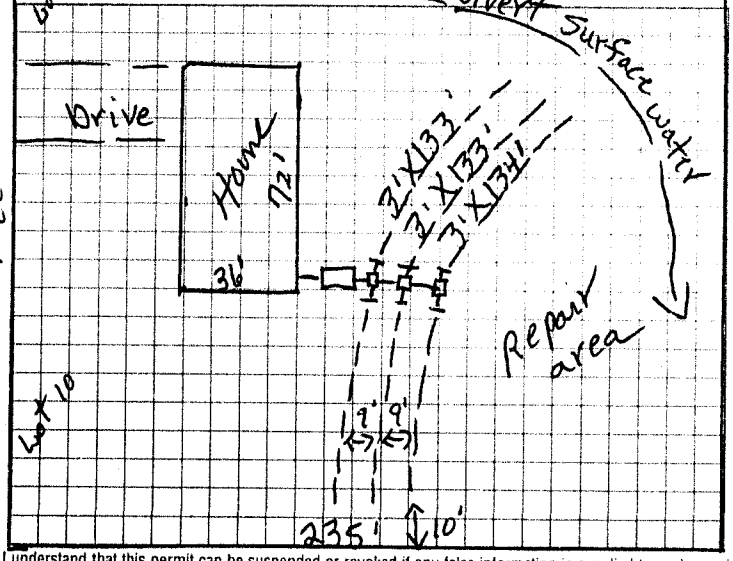

AS BUILT SKETCH

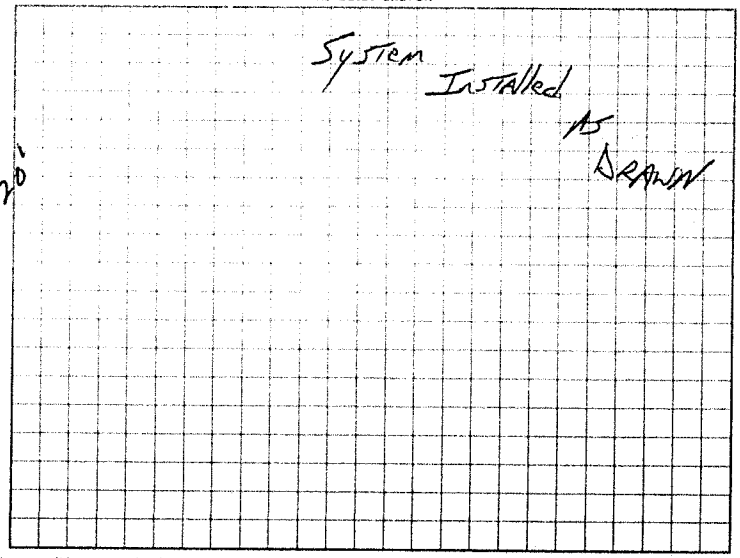

I understand that this permit can be suspended or revoked if any false information is supplied toward securing the permit/any unauthorized changes are made to the site/any unauthorized changes are made in the installation of the system. Improvement Permit with plat valid without expiration. Improvement Permit with site plan valid for sixty months. Authorization to Construct is valid for a period equal to that of Improvement Permit – not to exceed sixty months.

Signed: date 11-2-98 Installed by: Jody TRAVIS

Improvement Permit by: R. C. Moore date 10-31-98 Operation Permit by: date May 10 2000

Authorization to Construct by: R. C. Moore date 10-31-98 Existing System Inspection by: date

HEALTH DEPT. COPY: WHITE INSPECTION COPY (FINAL): GREEN OWNER COPY (FINAL): YELLOW INSPECTION COPY (INITIAL): PINK OWNER COPY (INITIAL): GOLD