11:00 Tommy Frye

IREDELL COUNTY HEALTH DEPARTMENT

STATESVILLE 704-878-5305 MOORESVILLE 704-664-5281

IMPROVEMENT PERMIT / CERTIFICATE OF COMPLETION / OPERATION PERMIT / EXISTING SYSTEM INSPECTION

PROPERTY DESCRIPTION NO. 22704 DATE 4-1-96 TAX MAP NO. 10K-1-A-11 Watershed: ☐ Yes ☑ No

OWNER OR CONTRACTOR Bobby Anderson PHONE: Business _____ Home 546-2273

ADDRESS 231 Hinder Rd Harmony

LOCATION 21 N TL Jennings Rd TR Reeves Rd TL milestone 1/4mi left

SUBDIVISION Ambelside BLOCK / SECTION _____ LOT 11 LOT AREA 110'X235' SITE CLASS PS DESIGN FLOW 360 L.T.A.R. .33

Septic Tank: 1000 Gallons; STB 1027P Date 6/8/96
Pump Tank: _____ Gallons; PT _____ Date _____
Pump Make: _____ Model _____ Serial No. _____
Nitrification Field: No Fields 1 Square Feet 1080 Linear Feet 360
No Lines 4 Trench Width 36" Max Trench Bottom Depth 36" Gravel Depth 12"

☑ New System ☐ Repair System Type: I II III IV V VI
System Description: Conv. Gravity
Repair System Description: " "
Maintenance Agreement Required: ☐ Yes ☑ No
☐ Slab ☑ Crawl Space ☐ Basement w/plumbing ☐ Basement wo/plumbing


☐ House/Mod. Home No. Bedrooms 3
☐ Mobile Home No. Bathrooms 3
☐ Business No. Employees _____
☐ Other _____

Water Supply: ☐ Individual ☐ Community ☑ Public


Comments: Landscape by Placing water Diversion trench on lot line between lots 11 & 10 & Divert water to back corner Then Reil Vant Towards back to Eliminate Standing water

Comments: Replaces Permit Issued 4-12-94 To Roberts. King

INITIAL SITE SKETCH

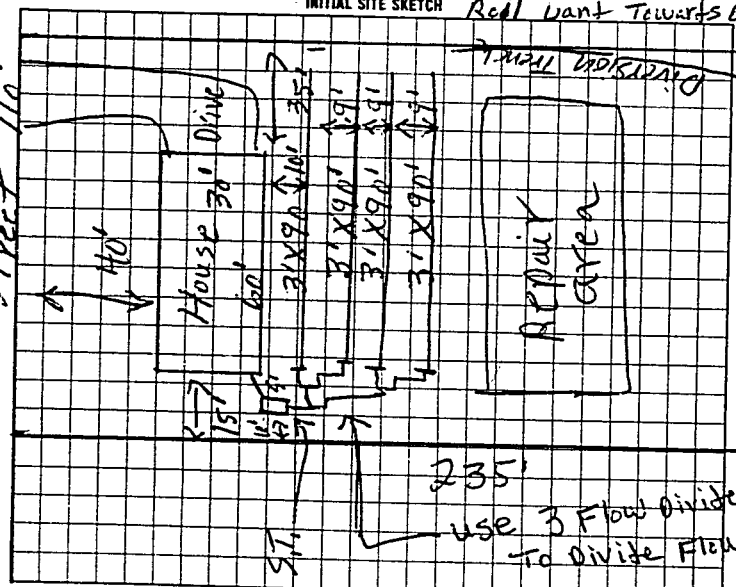

AS BUILT SKETCH

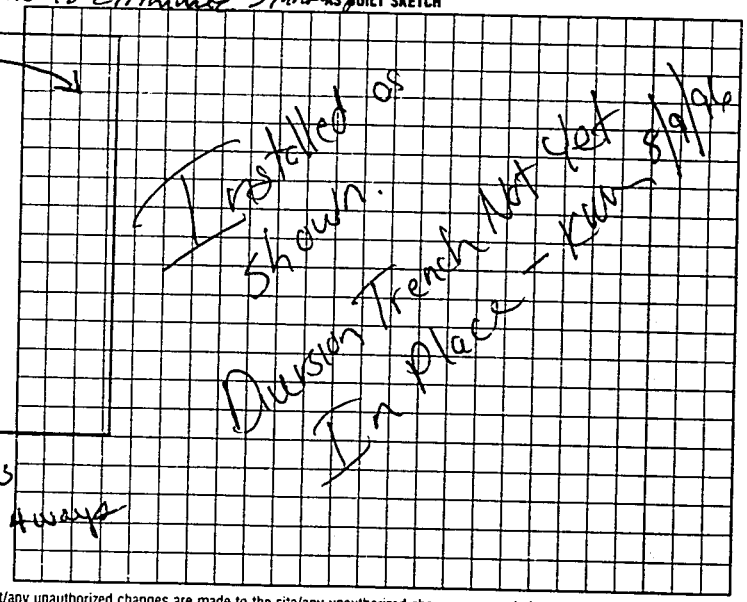

I understand that this permit can be suspended or revoked if any false information is supplied toward securing the permit/any unauthorized changes are made to the site/any unauthorized changes are made in the installation of the system.

Signed: x Bobby Anderson

Improvement Permit by: J. C. Moore date 4-1-96

Existing System Inspection by: J. C. Moore date 4-1-96

Installed by: Tommy Frye

Certificate of Completion by: _____ date _____

Operation Permit by: J. C. Moore date 1-15-98

Authorization to Const. Expires 60 moz from issue

Const. HEALTH DEPT. COPY WHITE — INSPECTION COPY (FINAL) GREEN — OWNER COPY (FINAL) YELLOW — INSPECTION COPY (INITIAL) PINK — OWNER COPY (INITIAL) BLUE