# IREDELL COUNTY HEALTH DEPARTMENT

STATESVILLE 704-878-5305 MOORESVILLE 704-664-5281

## IMPROVEMENT PERMIT / AUTHORIZATION TO CONSTRUCT / OPERATION PERMIT / EXISTING SYSTEM INSPECTION

DATE 10/31/00

PERMIT# [redacted] 92282 PIN# [redacted] 4747986667

OWNER OR CONTRACTOR DALE WEDDINGTON PHONE: Business 838-0891 Home

ADDRESS 537 CLOUD DRIVE STATESVILLE 28625

LOCATION 21 N. TO JENNINGS RD - TR REEVIS RD - TL MELLSTONE - LOT 12 ON LT

SUBDIVISION AMBLESIDE BLOCK / SECTION LOT 12 LOT AREA SITE CLASS PS DESIGN FLOW 360GPD L.T.A.R. .3 gal/ft²

Septic Tank: 1000 Gallons; STB 825 Date 10-7-00

Pump Tank: Gallons; PT Date

Pump Make: Model Serial No.

Nitrification Field: No Fields 1 Square Feet 900 Linear Feet 300

No Lines 4@75' Trench Width 36" Max Trench Bottom Depth 36" Gravel Depth n/a

☒ New System ☐ Repair System Type: I, II, III, IV, V, VI

System Description: GRAVITY 25% REDUCTION

Repair System Description: SAME

Maintenance Agreement Required: ☐ Yes ☒ No

☒ House/Mod. Home No. Bedrooms 3

☐ Mobile Home No. Bathrooms 3

☐ Business No. Employees

☐ Other


☐ Slab ☒ Crawl Space ☐ Basement w/plumbing ☐ Basement wo/plumbing

Water Supply: ☐ Individual ☒ Public ☐ Community


Comments:/Conditions:

Comments:/Conditions: POLYLOK FILTER + RISERS - INSTALLED AS SHOWN WITH EZLAY SECTIONS

INITIAL SITE SKETCH 1"=40'

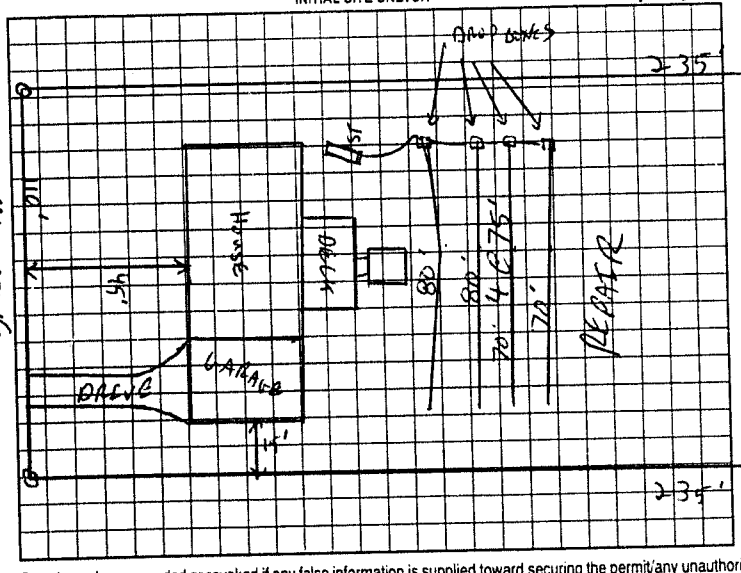


AS BUILT SKETCH

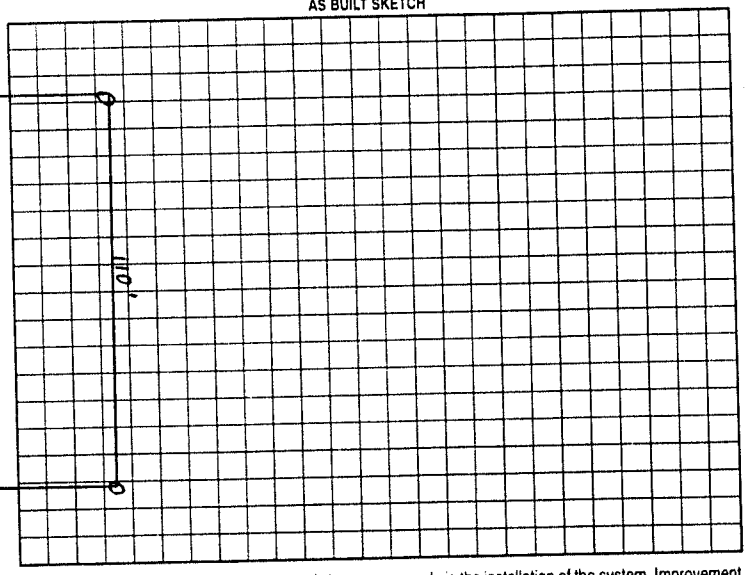


Permit can be suspended or revoked if any false information is supplied toward securing the permit/any unauthorized changes are made to the site/any unauthorized changes are made in the installation of the system. Improvement Permit with plat valid without expiration. Improvement Permit with site plan valid for sixty months. Authorization to Construct is valid for a period equal to that of Improvement Permit – not to exceed sixty months.

Signed: date 1-14-00 Installed by: STATESVILLE BACKHOE

Improvement Permit by: C. Hoyle RS date 10/31/00 Operation Permit by: RSI date 7-12-01

Authorization to Construct by: C. Hoyle RS date 10/31/00 Existing System Inspection by: date

HEALTH DEPT. COPY. WHITE OWNER COPY (FINAL). YELLOW OWNER COPY (INITIAL). PINK