IREDELL COUNTY HEALTH DEPARTMENT

STATESVILLE 704-878-5305 MOORESVILLE 704-664-5281

IMPROVEMENT PERMIT / AUTHORIZATION TO CONSTRUCT / OPERATION PERMIT / EXISTING SYSTEM INSPECTION

PERMIT# 10405 PIN# 4747-98-9005 DATE 01-30-02

OWNER OR CONTRACTOR JACK BORDERS PHONE Business 704-902-3907 cell Home 828-478-9574

ADDRESS 188 KNOX FARM RD STATESVILLE NC 28677

LOCATION 21N, ⓒ JENNINGS, ⓑ REEVES, ⓒ MILLSTONE, LOT ON RT

SUBDIVISION AMBLESIDE BLOCK / SECTION LOT 29 LOT AREA 1.57 SITE CLASS PS DESIGN FLOW 360 LTAR .3

Septic Tank 1000 Gallons STB 794 Date 4-20-02
Pump Tank: 1000 Gallons PT 283 Date 4-9-02
Pump Make: ZOELLER Model N152-A Serial No 152-0002
Nitrification Field: No Fields 1 Square Feet 6x=1200 Linear Feet 300'
No Lines 4X75' Trench Width 36" Max Trench Bottom Depth 36" Gravel Depth N/A

X New System Repair System Type I II III IV V
System Description PUMP 2 s+/c RED
Repair System Description LP PANEL
Maintenance Agreement Required Yes X No

X House/Mod Home No Bedrooms 3
Mobile Home No Bathrooms 2
Business No Employees
Other


Water Supply: ☐ Individual X Public ☐ Community

Slab X Crawl Space Basement w/plumbing Basement wo/plumbing

Comments/Conditions: ① PAD FOR HOUSE & BUILDING POSITIVE DRAINAGE RULE MUST BE FILLED, NOT CUT! ② REDIRECT DRAINAGE WAY AROUND EGRESS OF HOUSE TO DITCH ③ MAINTAIN SETBACKS ④ CALL PRIOR TO

Comments/Conditions: INSTALLATION FOR FLABOUT & PUMP SIZING ⑤ IF PAD IS CUT, LOT, MAY BECOME UNSUITABLE DUE TO SETBACKS, ⑥ INSTALL LINES ON CONTOUR ⑦ LOT TO BROWED UP TO FLABOUT.

INITIAL SITE SKETCH 1"=40'

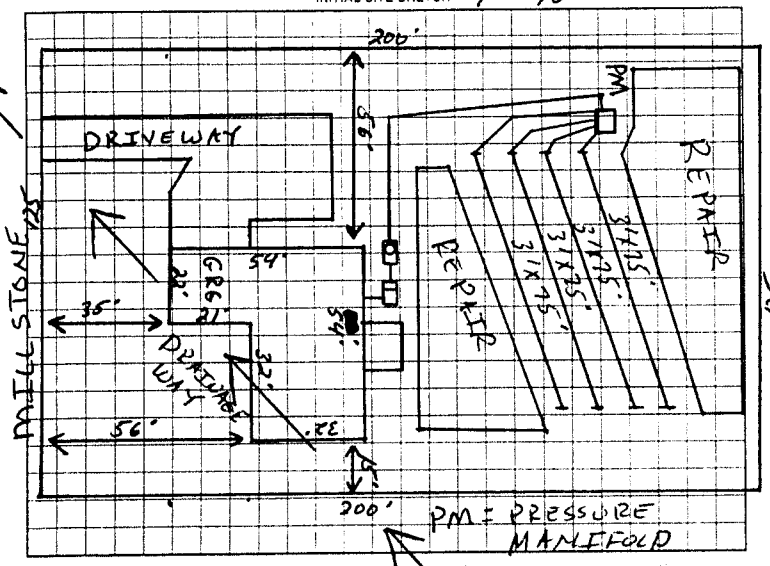

AS BUILT SKETCH

ZABEL FILTER, MARKER & RISERS
V'D LINES, TANK & SUPPLY LINES
NEEDS PUMP, PRESSURED ELECTRICAL V'D
EVERYTHING V'D OK
TANKS REDEEPED

Permit can be suspended or revoked if any false information is supplied toward securing the permit any unauthorized changes are made to the site any unauthorized changes are made in the installation of the system. Improvement Permit with plat valid without expiration. Improvement Permit with site plan valid for sixty months. Authorization to Construct is valid for a period equal to that of Improvement Permit – not to exceed sixty months.

Signed: date 1-31-2002 Installed by BEATTY GRADING

Improvement Permit by: KS date 01-30-02 Operation Permit by: KS date 07-03-02

Authorization to Construct by: date 01-31-02 Existing System Inspection by date

HEALTH DEPT COPY WHITE OWNER COPY (FINAL) YELLOW OWNER COPY (INITIAL) PINK