~~6695~~ ~~5434~~ ~~22876~~ #60175

IREDELL COUNTY HEALTH DEPARTMENT

STATESVILLE 704-878-5305 MOORESVILLE 704-664-5281

IMPROVEMENT PERMIT / CERTIFICATE OF COMPLETION / OPERATION PERMIT / EXISTING SYSTEM INSPECTION

Watershed: ☐ Yes ☑ No

PROPERTY DESCRIPTION NO. 22876 DATE 1-3-96 TAX MAP NO. 10K-1-A-28

OWNER OR CONTRACTOR Jack Borders PHONE: Business Home 881-0025

ADDRESS 188 Knox Fm Rd

LOCATION 21N To Jennings Rd TR Reeves Rd To millstone Drive 1/8mi lot Rt

SUBDIVISION Amblesite BLOCK / SECTION LOT 28 LOT AREA 110'X200' SITE CLASS PS DESIGN FLOW 360 L.T.A.R. 135

Septic Tank: 1000 Gallons: STB 1017 Date 9-11-96

Pump Tank: Gallons: PT Date

Pump Make: Model Serial No.

Nitrification Field: No Fields 1 Square Feet 1050 Linear Feet 350

No Lines 6 Trench Width 36" Max Trench Bottom Depth 36+ Gravel Depth 12"

☑ New System ☐ Repair System Type: I II III IV V VI

System Description: Conv. Gravity

Repair System Description: Pump to Conv. Lines

Maintenance Agreement Required: ☐ Yes ☑ No

☐ House/Mod. Home No. Bedrooms 3

☐ Mobile Home No. Bathrooms 2

☐ Business No. Employees

☐ Other


☐ Slab ☑ Crawl Space ☐ Basement w/plumbing ☐ Basement wo/plumbing

Water Supply: ☐ Individual ☐ Community ☑ Public


Comments:

Comments:

INITIAL SITE SKETCH

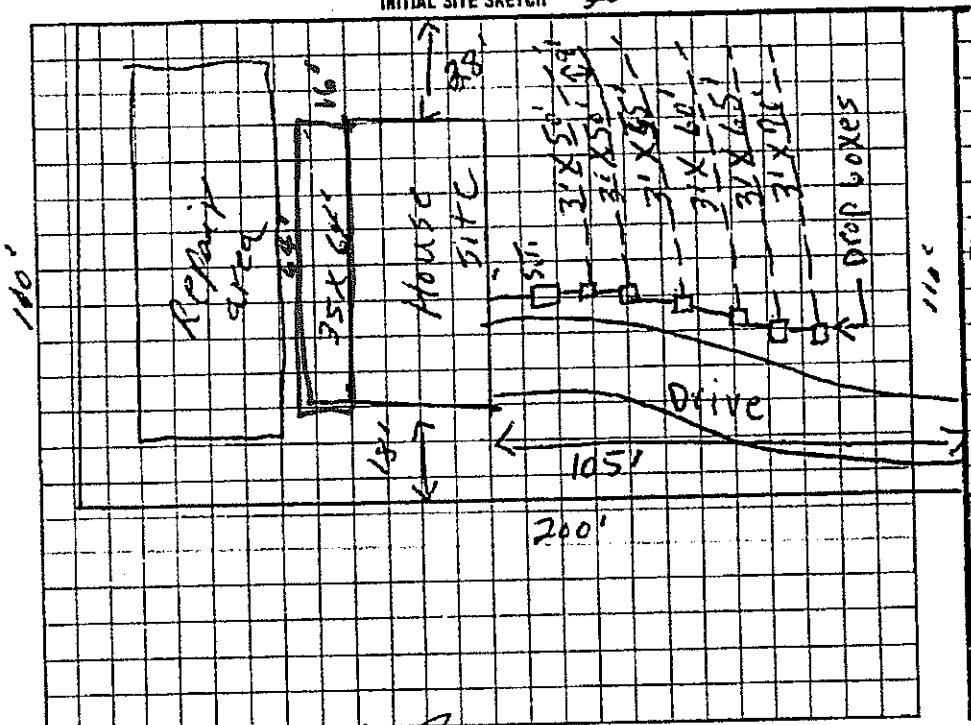

AS BUILT SKETCH

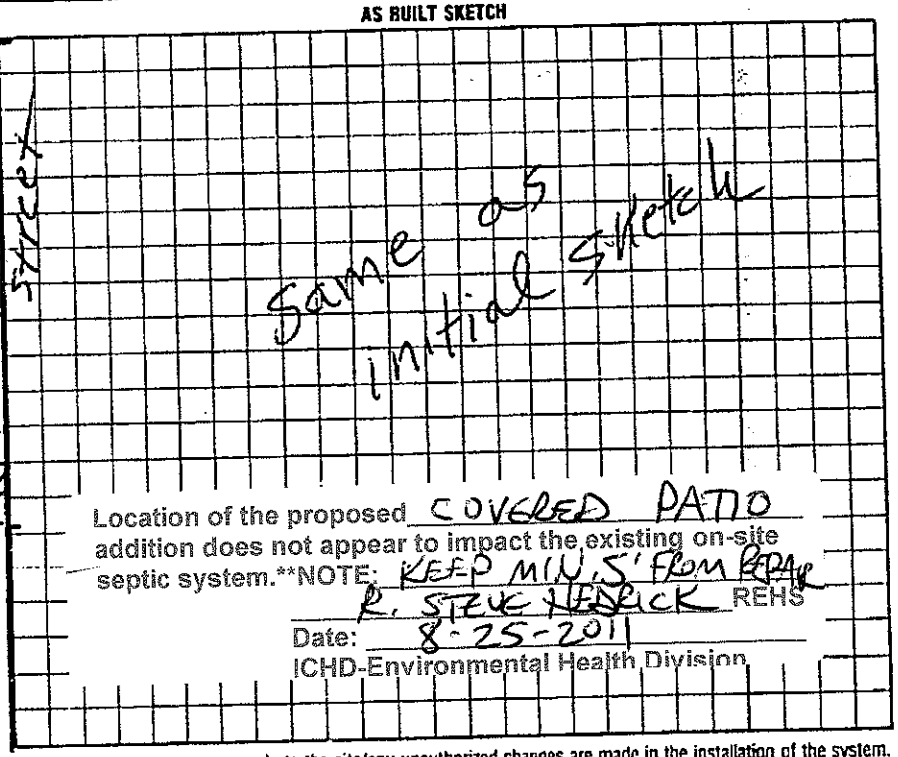

Location of the proposed COVERED PATIO addition does not appear to impact the existing on-site septic system.**NOTE: KEEP MIN. 5' FROM REPAIR

R. STEVE HENDRICK REHS

Date: 8-25-2011

ICHD-Environmental Health Division

I understand that this permit can be suspended or revoked if any false information is supplied toward securing the permit/any unauthorized changes are made to the site/any unauthorized changes are made in the installation of the system.

Signed: X

Improvement Permit by: R.C. moore date 1-3-95

Existing System Inspection by R.C. moore date 1-3-95

Installed by: Dale FOX Alex. Co.

Certificate of Completion by: date

Operation Permit by R.C. moore date 10-25-96

to const HEALTH DEPT. COPY. WHITE INSPECTION COPY (FINAL) GREEN OWNER COPY (FINAL) YELLOW INSPECTION COPY (INITIAL) PINK OWNER COPY (INITIAL) GOLD

Authorization to count Expires 60 mos. from issue to

0 0 2 5 7 3