4:00

IREDELL COUNTY HEALTH DEPARTMENT

STATESVILLE 704-878-5305 MOORESVILLE 704-664-5281

IMPROVEMENT PERMIT / AUTHORIZATION TO CONSTRUCT / OPERATION PERMIT / EXISTING SYSTEM INSPECTION

PERMIT# 77597 PIN# 4747 98 9559 DATE 11-12-98

OWNER OR CONTRACTOR Doug M. Schatte PHONE: Business _____ Home 663 6812

ADDRESS PO Box 74 Turnersburg

LOCATION 21N TL Jennings TR Reeves TL millstone 6csite 164 millstone Dr.

SUBDIVISION Ambelsite BLOCK / SECTION _____ LOT 8 24 LOT AREA 1.59 acres SITE CLASS. PS DESIGN FLOW 360 L.T.A.R. 1.33

Septic Tank: 1000 Gallons; STB 1012 Date 11-12-98
Pump Tank: _____ Gallons; PT _____ Date _____
Pump Make: _____ Model _____ Serial No. _____
Nitrification Field: No Fields 1 Square Feet 1080 Linear Feet 360
No Lines 4 Trench Width 36" Max Trench Bottom Depth 36" Gravel Depth 12"

☑ New System ☐ Repair System Type: I, II, III, IV, V, VI
System Description: conv. Gravity
Repair System Description: Pump To Conv.
Maintenance Agreement Required: ☐ Yes ☑ No
☐ Slab ☐ Crawl Space ☐ Basement w/plumbing ☐ Basement wo/plumbing


☑ House/Mod. Home No. Bedrooms 3
☐ Mobile Home No. Bathrooms 2½
☐ Business No. Employees _____
☐ Other _____

Water Supply: ☐ Individual ☑ Public ☐ Community


Comments:/Conditions:

Comments:/Conditions:

INITIAL SITE SKETCH

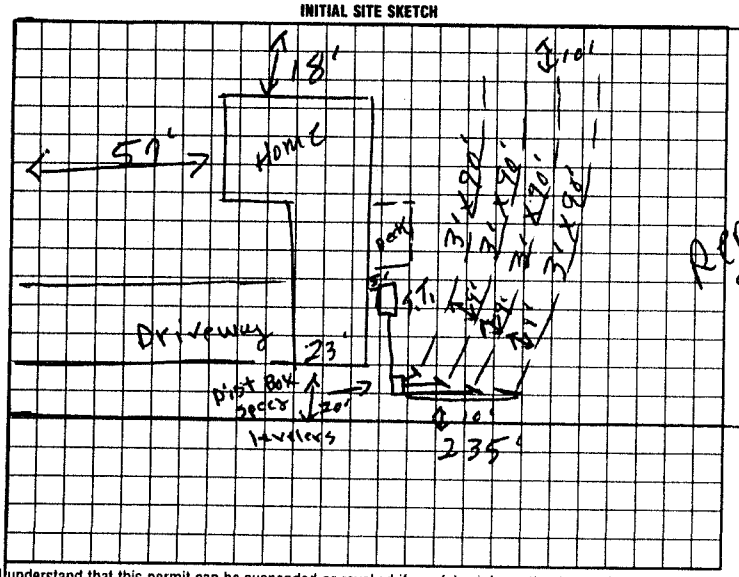

AS BUILT SKETCH

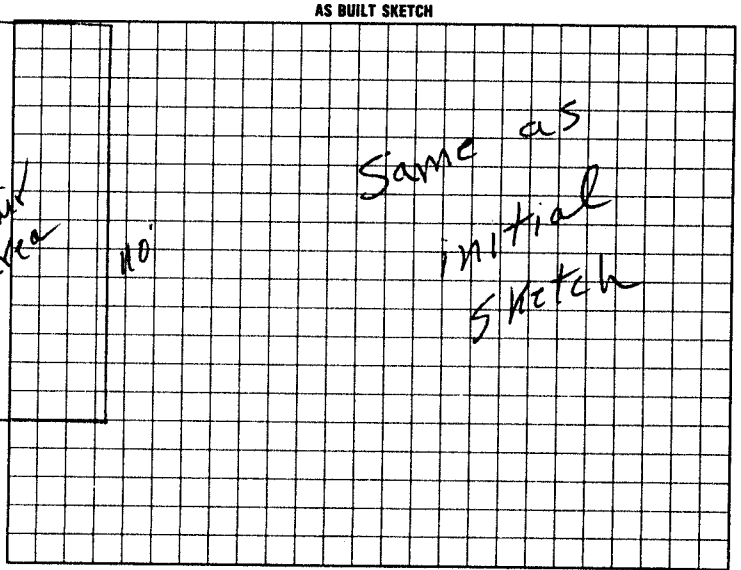

I understand that this permit can be suspended or revoked if any false information is supplied toward securing the permit/any unauthorized changes are made to the site/any unauthorized changes are made in the installation of the system. Improvement Permit with plat valid without expiration. Improvement Permit with site plan valid for sixty months. Authorization to Construct is valid for a period equal to that of Improvement Permit – not to exceed sixty months.

Signed: X _____ date _____ Installed by: David Yountz

Improvement Permit by: D. C. moore date 11-12-98 Operation Permit by: D. C. moore date 2-15-99

Authorization to Construct by: D. C. moore date 11-12-98 Existing System Inspection by: _____ date _____

HEALTH DEPT. COPY: WHITE INSPECTION COPY (FINAL): GREEN OWNER COPY (FINAL): YELLOW INSPECTION COPY (INITIAL): PINK OWNER COPY (INITIAL): GOLD