IREDELL COUNTY HEALTH DEPARTMENT

STATESVILLE 704-878-5305 MOORESVILLE 704-664-5281

IMPROVEMENT PERMIT / AUTHORIZATION TO CONSTRUCT / OPERATION PERMIT / EXISTING SYSTEM INSPECTION

PERMIT# 79300 PIN# 4747994914 DATE 2-16-99

OWNER OR CONTRACTOR Bobby Reavis PHONE: Business [redacted] Home 876 0766

ADDRESS 649 Blackwelder Rd

LOCATION 21 N to Jennings TR Blackwelder 1 mi Rt

SUBDIVISION _____ BLOCK / SECTION _____ LOT 5 LOT AREA 17.23 acres SITE CLASS PS DESIGN FLOW 360 L.T.A.R. 13

Septic Tank: 1000 Gallons; STB 620 Date 2-2-99
Pump Tank: _____ Gallons; PT _____ Date _____
Pump Make: _____ Model _____ Serial No. _____
Nitrification Field: No Fields 4 Square Feet 1200 Linear Feet 400
No Lines 4 Trench Width 36" Max Trench Bottom Depth 36" Gravel Depth 12"

☒ New System ☐ Repair System Type: I, II, III, IV, V, VI
System Description: Conv. Gravity
Repair System Description: " "
Maintenance Agreement Required: ☐ Yes ☒ No
☐ Slab ☐ Crawl Space ☒ Basement w/plumbing ☐ Basement wo/plumbing


☒ House/Mod. Home No. Bedrooms 3
☐ Mobile Home No. Bathrooms 3
☐ Business No. Employees _____
☐ Other _____

Water Supply:
☒ Individual
☐ Public
☐ Community
well next door


Comments/Conditions:

Comments/Conditions 1091'

INITIAL SITE SKETCH

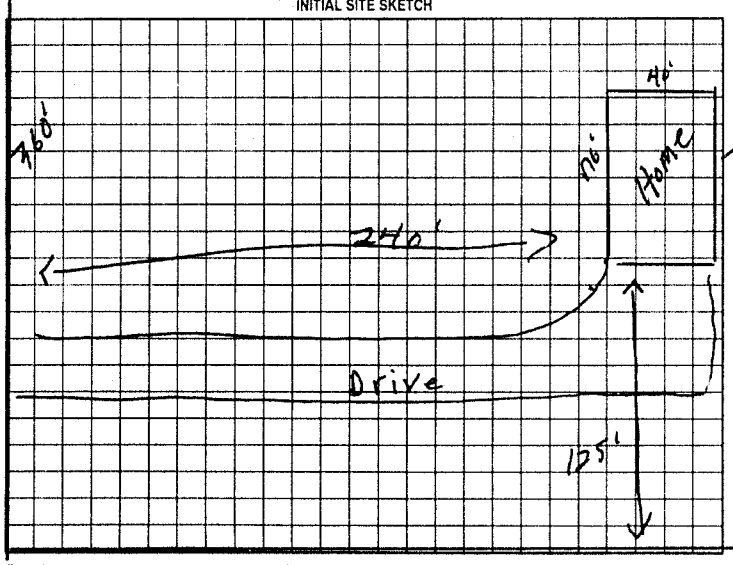

AS BUILT SKETCH

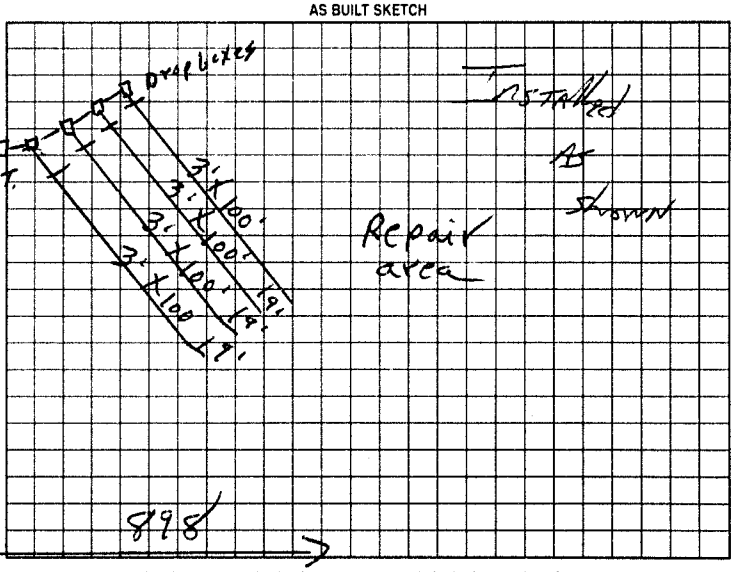

Permit can be suspended or revoked if any false information is supplied toward securing the permit/any unauthorized changes are made to the site/any unauthorized changes are made in the installation of the system. Improvement Permit with plat valid without expiration. Improvement Permit with site plan valid for sixty months. Authorization to Construct is valid for a period equal to that of Improvement Permit – not to exceed sixty months.

Signed: X Bobby Reavis date 2-16-99 Installed by: Tommy Reavis

Improvement Permit by: R. C. Moore date 2-16-99 Operation Permit by: [illegible] date 11-18-99

Authorization to Construct by: R. C. Moore date 2-16-99 Existing System Inspection by: _____ date _____

HEALTH DEPT. COPY: WHITE OWNER COPY (FINAL) YELLOW OWNER COPY (INITIAL) PINK