IREDELL COUNTY HEALTH DEPARTMENT

STATESVILLE 704-878-5305 MOORESVILLE 704-664-5281

IMPROVEMENT PERMIT / AUTHORIZATION TO CONSTRUCT / OPERATION PERMIT / EXISTING SYSTEM INSPECTION

PERMIT# 136237 PIN# 4748-12-5583 DATE 6-17-06

OWNER OR APPLICANT DIXIELAND, INC PHONE: Business 704-202-4971 Home 704-876-6162

ADDRESS 823 JENNINGS ROAD STATESVILLE NC 28625

LOCATION I-S 21 N, TL JENNINGS RD, TL REDEMPTION ROAD, TL TO POULTRY HOUSE, CROSS DAM, BEAR LEFT TO FACILITY

SUBDIVISION _____ BLOCK / SECTION _____ LOT _____ LOT AREA ACREAGE 56.61 ACRES SITE CLASS PS DESIGN FLOW 480 L.T.A.R. 0.30 GPD/FT2

Septic Tank: 1000 Gallons; STB RST 895-1000 Date 3-01-07

Pump Tank: 1000 Gallons; PT _____ Date 2-25-07

Pump Make: _____ Model _____ Serial No. _____

Nitrification Field: No Fields 1 Square Feet 1600 Linear Feet 540

No Lines FIVE Trench Width 36" Max Trench Bottom Depth 36" Gravel Depth 12"

☑ New System ☐ Repair ☐ Expansion System Type: I II (III) IV V VI

System Description: CONVENTIONAL, PUMP

Repair System Description: CONVENTIONAL, PUMP

Maintenance Agreement Required: ☐ Yes ☐ No

☐ House/Mod. Home ☐ Mobile Home ☐ Business ☑ Other THERAPEUTIC CAMP

No. Bedrooms _____ No. Persons 8 No. Employees _____


Water Supply: ☑ Individual ☐ Public ☐ Community WELL

☐ Gravity ☑ Pressure ☐ Slab ☐ Crawl Space ☐ Basement w/plumbing ☐ Basement wo/plumbing


Comments/Conditions: ① AN "ACCEPTED" SYSTEM MAY ALSO BE USED. ② SEE ATTACHED SHEETS FOR PUMP AND PRESSURE MANIFOLD REQUIREMENTS REPAIR AREA

Comments/Conditions: Poly-Flock Filter

INITIAL SITE SKETCH

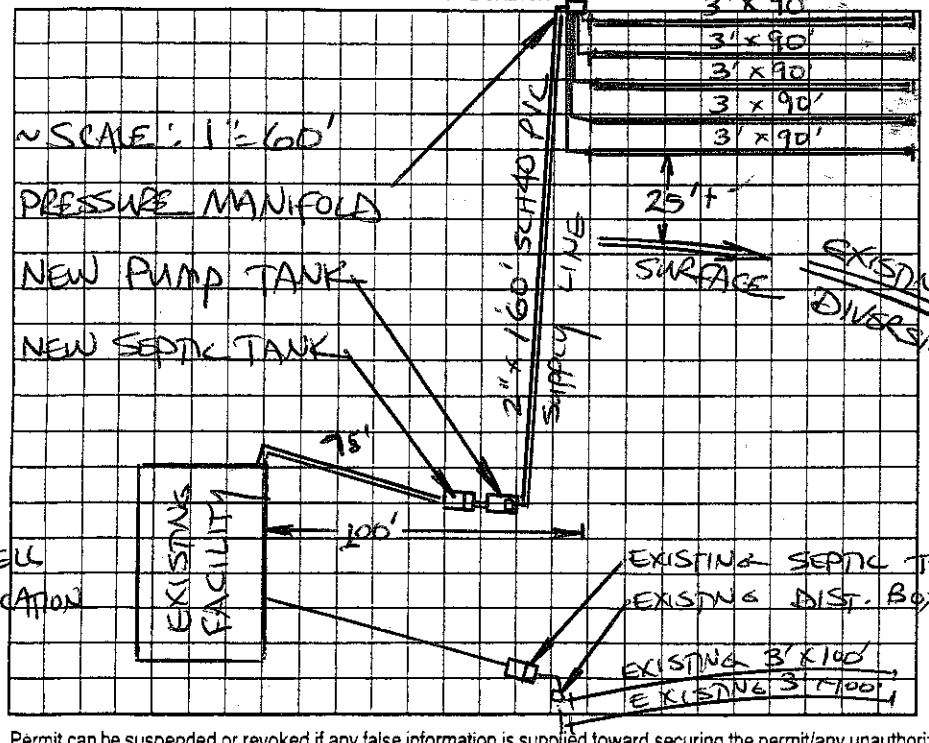

AS BUILT SKETCH

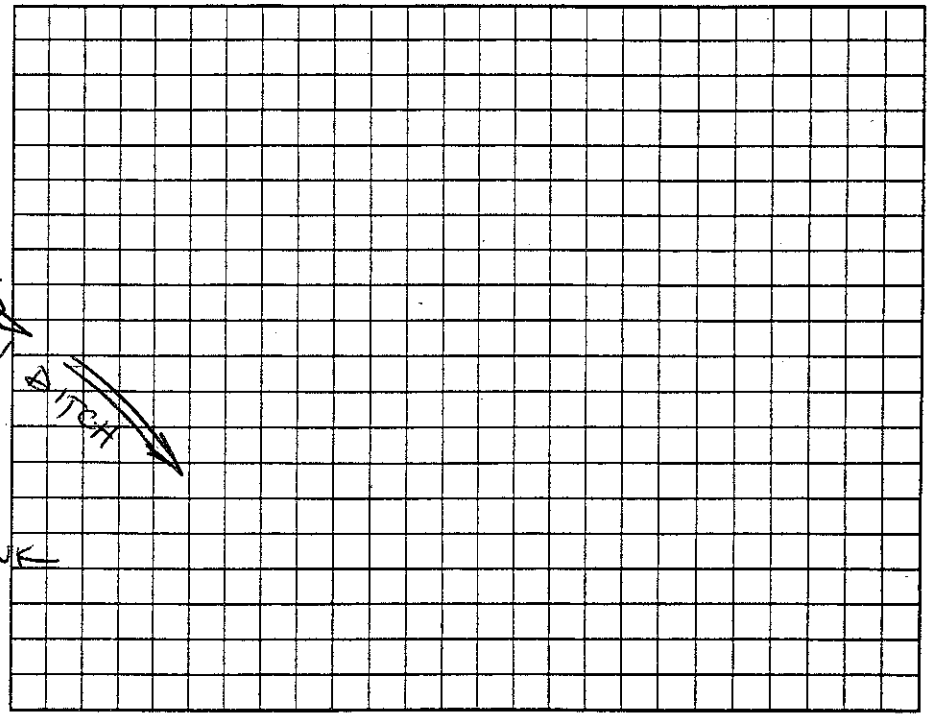

Permit can be suspended or revoked if any false information is supplied toward securing the permit/any unauthorized changes are made to the site/any unauthorized changes are made in the installation of the system. Improvement Permit with plat valid without expiration. ☐ Improvement Permit with site plan valid for sixty months ☑ Authorization to Construct is valid for a period equal to that of Improvement Permit – not to exceed sixty months.

Signed: Crystal Dowdle date 6-21-06 Installed by: J Rogers

Improvement Permit by: STEVE HEDRICK date 6-17-06 Operation Permit by: _____ date 7-16-07

Authorization to Construct by: STEVE HEDRICK date 6-17-06 Existing System Inspection by: _____ date _____

HEALTH DEPT. COPY: WHITE OWNER COPY (FINAL): YELLOW OWNER COPY (INITIAL): PINK