IREDELL COUNTY HEALTH DEPARTMENT

STATESVILLE 704-878-5305 (4) MOORESVILLE 704-664-5281

IMPROVEMENT PERMIT / AUTHORIZATION TO CONSTRUCT / OPERATION PERMIT / EXISTING SYSTEM INSPECTION

PERMIT# 19218 PIN# 4748-12-5583 DATE 1-28-05

OWNER OR CONTRACTOR REGINA CECIL PHONE: Business _____ Home 704-876-6162

ADDRESS 823 JENNINGS ROAD, STATESVILLE, NC 28625

LOCATION US21 N, TL JENNINGS ROAD, TL REDEMPTION ROAD, TL TO POULTRY HOUSE, CROSS DAM, BEAR LEFT

SUBDIVISION _____ BLOCK / SECTION _____ LOT _____ LOT AREA ACREAGE SITE CLASS. PS DESIGN FLOW 240 L.T.A.R. 0.30 GPD/FT²

Septic Tank: 1000 Gallons; STB 825 Date 12-8-03
Pump Tank: _____ Gallons; PT _____ Date _____
Pump Make: _____ Model _____ Serial No. _____
Nitrification Field: No Fields 1 Square Feet 810 Linear Feet 270
No Lines TWO Trench Width 36" Max Trench Bottom Depth 36" Gravel Depth 12"

☑ New System ☐ Repair System Type: I (II) III, IV, V, VI
System Description: CONVENTIONAL, GRAVITY
Repair System Description: CONVENTIONAL, GRAVITY
Maintenance Agreement Required: ☐ Yes ☑ No


☑ House/Mod. Home No. Bedrooms 3
☐ Mobile Home No. Bathrooms _____
☐ Business No. Employees _____
☐ Other _____
☑ Slab ☐ Crawl Space ☐ Basement w/plumbing ☐ Basement wo/plumbing

Water Supply: ☐ Individual ☑ Public ☐ Community


Comments:/Conditions: ① CONSTRUCT SURFACE DIVERSION DITCH ABOVE SYSTEM AS SHOWN TO PREVENT SCOURING ② KEEP SYSTEM MINIMUM 50' FROM POND WATER LEVEL & 10' BELOW DIVERSION DITCH.

Comments:/Conditions: SEPTIC TANK WITH RISERS INSTALLED USING "POLYLOK" FILTER

INITIAL SITE SKETCH

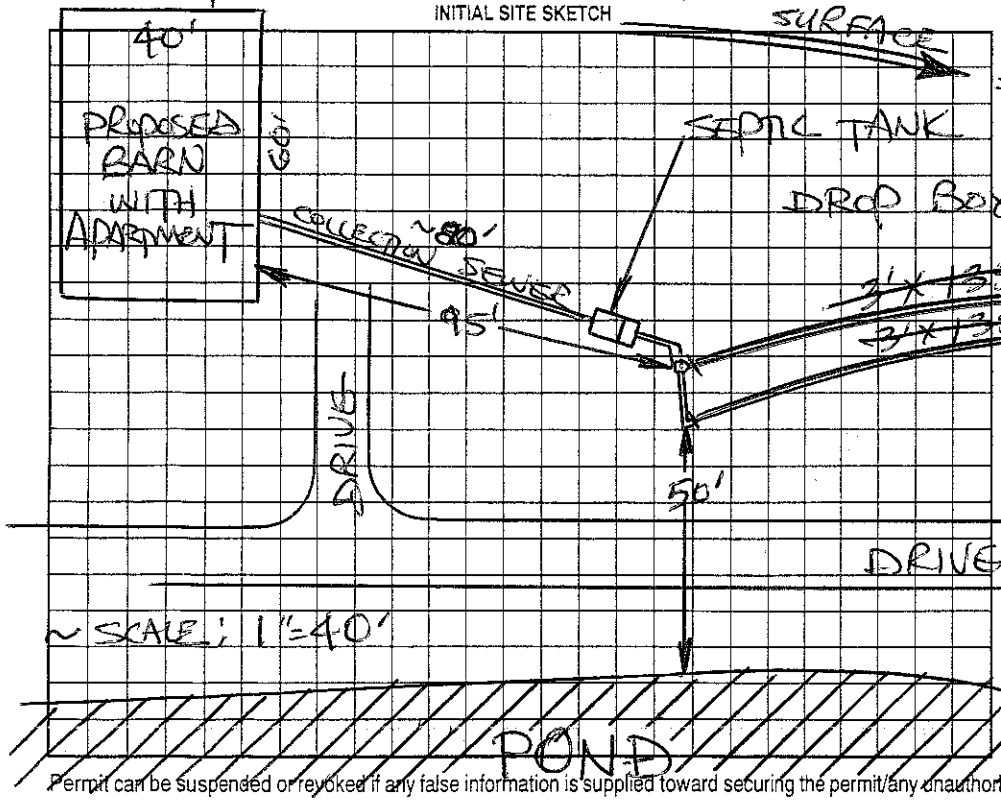

AS BUILT SKETCH

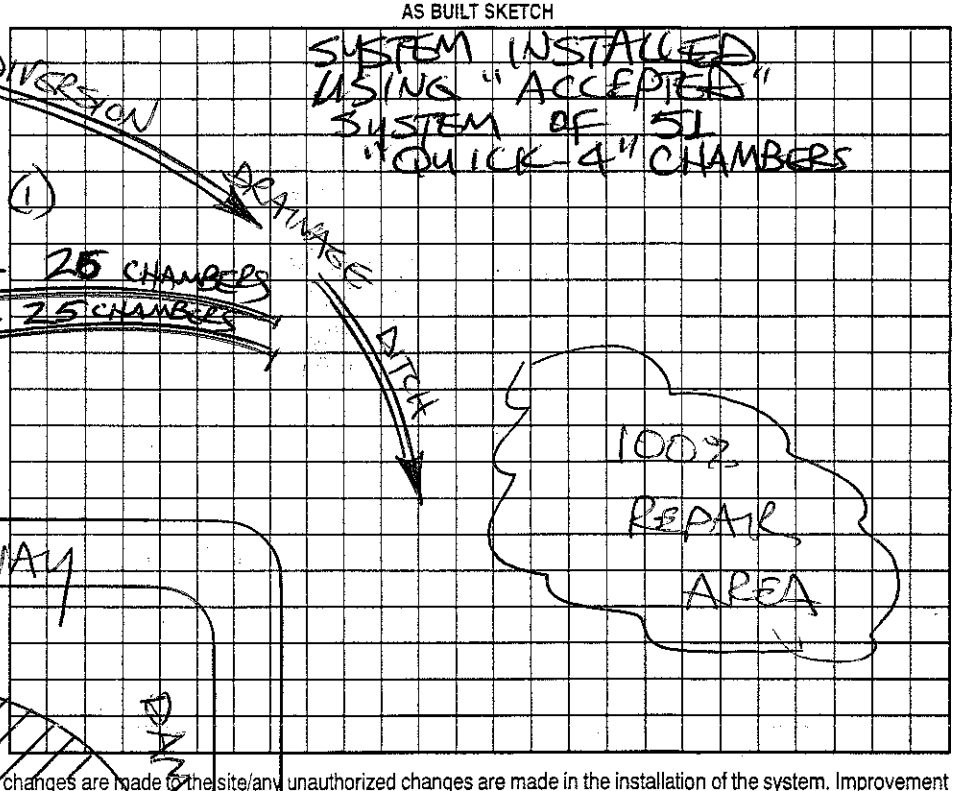

Permit can be suspended or revoked if any false information is supplied toward securing the permit/any unauthorized changes are made to the site/any unauthorized changes are made in the installation of the system. Improvement Permit with plat valid without expiration. Improvement Permit with site plan valid for sixty months. Authorization to Construct is valid for a period equal to that of Improvement Permit – not to exceed sixty months.

Signed: + Regina K Cecil date 1/28/05 Installed by: ROWAN SEPTIC

Improvement Permit by: STEVE HEDRICK date 1-28-05 Operation Permit by: STEVE HEDRICK date 4-29-05

Authorization to Construct by: STEVE HEDRICK date 1-28-05 Existing System Inspection by: _____ date _____

HEALTH DEPT. COPY: WHITE OWNER COPY (FINAL): YELLOW OWNER COPY (INITIAL): PINK