IREDELL COUNTY HEALTH DEPARTMENT

STATESVILLE 704-878-5305 (c1) MOORESVILLE 704-664-5281

IMPROVEMENT PERMIT / AUTHORIZATION TO CONSTRUCT / OPERATION PERMIT / EXISTING SYSTEM INSPECTION

PERMIT# 133530 PIN# 4748208762 DATE 3-1-06

OWNER OR APPLICANT Ginger Cecil PHONE: Business 704 876 6162 Home 704 202 4971

ADDRESS 213 Sundance Circle

LOCATION Jennings Rd N-L on Deer Crossing, R on Sundance Circle, 4th house on right LOT

SUBDIVISION Deer Crossing BLOCK / SECTION 4 LOT 66 LOT AREA .5218 SITE CLASS. DS DESIGN FLOW 360 L.T.A.R. .25

Septic Tank: 1000 Gallons; STB 875 Date 2-21-06

Pump Tank: 1000 Gallons; PT 302 Date 2-11-06

Pump Make: Zoeller Model N157 Serial No.

Nitrification Field: No Fields 1 Square Feet 1440 Linear Feet 240

No Lines 3 Trench Width 2' Max Trench Bottom Depth 36"

☒ New System ☐ Repair ☐ Expansion System Type: I II (III) IV V VI

System Description: LP 50% Reduction System

Repair System Description: LP 50% Reduction System

Maintenance Agreement Required: ☒ Yes ☐ No

☒ House/Mod. Home No. Bedrooms 3

☐ Mobile Home No. Persons

☐ Business No. Employees

☐ Other

Water Supply: ☐ Individual ☒ Public ☐ Community


Gravel Depth n/a ☐ Gravity ☒ Pressure ☐ Slab ☒ Crawl Space ☐ Basement w/plumbing ☐ Basement wo/plumbing

Comments/Conditions:

Either sleeve supply line 5' 10' on either side of drive or place 36" under driveway - Recommend sleeving

Comments/Conditions:

INITIAL SITE SKETCH

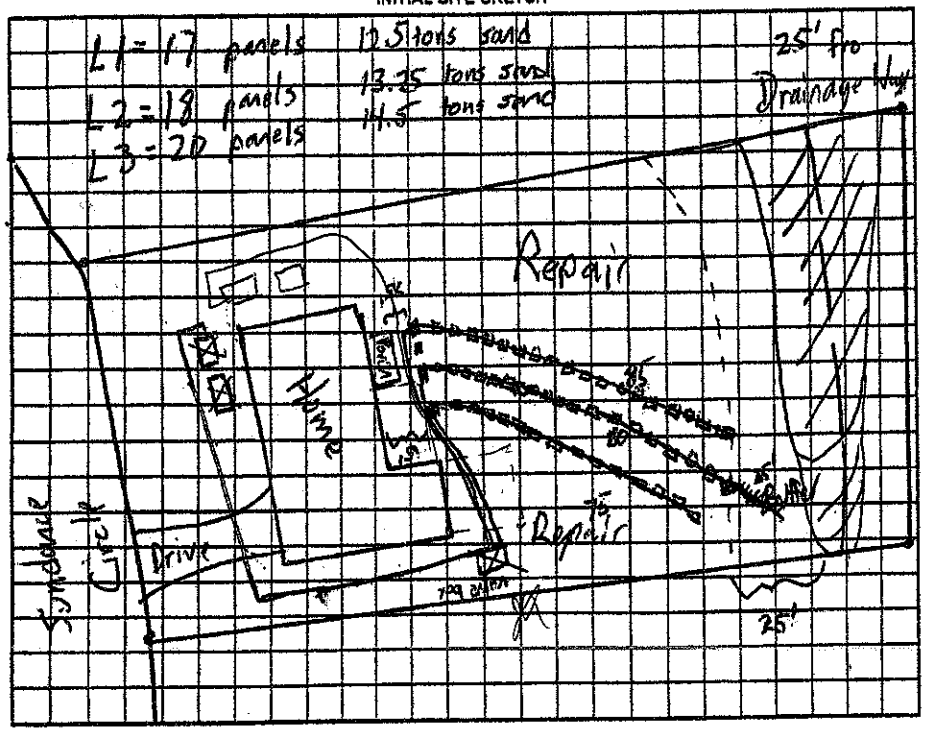

AS BUILT SKETCH

SYSTEM INSTALLED ACCORDING TO MINIMAL SITE SKETCH

The proposed sun deck addition does not appear to impact the existing septic system.

**NOTE:

R.S.

Date: 5-19-06

ICHD-Environmental Health Division

Permit can be suspended or revoked if any false information is supplied toward securing the permit/any unauthorized changes are made to the site/any unauthorized changes are made in the installation of the system. Improvement Permit with plat valid without expiration ☐ Improvement Permit with site plan valid for sixty months ☐ Authorization to Construct is valid for a period equal to that of Improvement Permit – not to exceed sixty months.

Signed: date

Improvement Permit by: date 3-1-06

Authorization to Construct by: date 3-1-06

Installed by: ROWAN SEPTIC

Operation Permit by: STEVE HENDRICK date 5-26-06

Existing System Inspection by: date

HEALTH DEPT COPY: WHITE OWNER COPY (FINAL): YELLOW OWNER COPY (INITIAL): PINK