IREDELL COUNTY HEALTH DEPARTMENT

THIS PERMIT REPLACES PREVIOUS ISSUED 4-26-04

STATESVILLE 704-878-5305 MOORESVILLE 704-664-5281

IMPROVEMENT PERMIT / AUTHORIZATION TO CONSTRUCT / OPERATION PERMIT / EXISTING SYSTEM INSPECTION

PERMIT# 120072 PIN# ~~4947-39-7486.62~~ 4748-20-9783 DATE 6-15-04

OWNER OR CONTRACTOR DIXIELAND, INC PHONE: Business 704-876-6162 Home 704-202-4971

ADDRESS 823 JENNINGS RD, STVL, NC 28625

LOCATION US 21 N, TL JENNINGS RD, TL DEER HAVEN TR SUNDANCE CIRCLE, 7TH LOT ON RIGHT

SUBDIVISION DEER CROSSING BLOCK / SECTION IV 4 LOT ~~67~~ LOT AREA ~~0.50~~ 0.508 ACRE SITE CLASS. PS DESIGN FLOW 360 L.T.A.R. 0.30 GPD/FT2

Septic Tank: 1000 Gallons; STB 825 Date 5-4-04

Pump Tank: 1000 Gallons; PT 302 Date 3-10-04

Pump Make: Zoeller Model N98 Serial No.

Nitrification Field: No Fields ___ Square Feet 1200 Linear Feet 200

No Lines FIVE Trench Width 24" Max Trench Bottom Depth 36" ~~Stone~~ Depth SAND 24"

☑ New System ☐ Repair System Type: I, II, III, IV, V, VI

System Description: 50% REDUCTION, PUMP

Repair System Description: 50% REDUCTION, LOW PRESSURE

Maintenance Agreement Required: ☐ Yes ☑ No ☐ Other

☑ House/Mod. Home No. Bedrooms 3

☐ Mobile Home No. Bathrooms 2.5

☐ Business No. Employees


☐ Slab ☑ Crawl Space ☑ Basement w/plumbing ☐ Basement wo/plumbing

Water Supply: ☐ Individual ☑ Public ☐ Community

Comments:/Conditions: INSTALL 45 PPBPS PANELS IN FIVE EQUAL LENGTH LINES AS SHOWN, SEE ATTACHED SHEETS FOR PUMP & PRESSURE MANIFOLD REQUIREMENTS.

Comments:/Conditions: - Installed pump, black & lt filter - pressure check, okay, 6/30/04 wgf

INITIAL SITE SKETCH SCALE: 1" = 40'

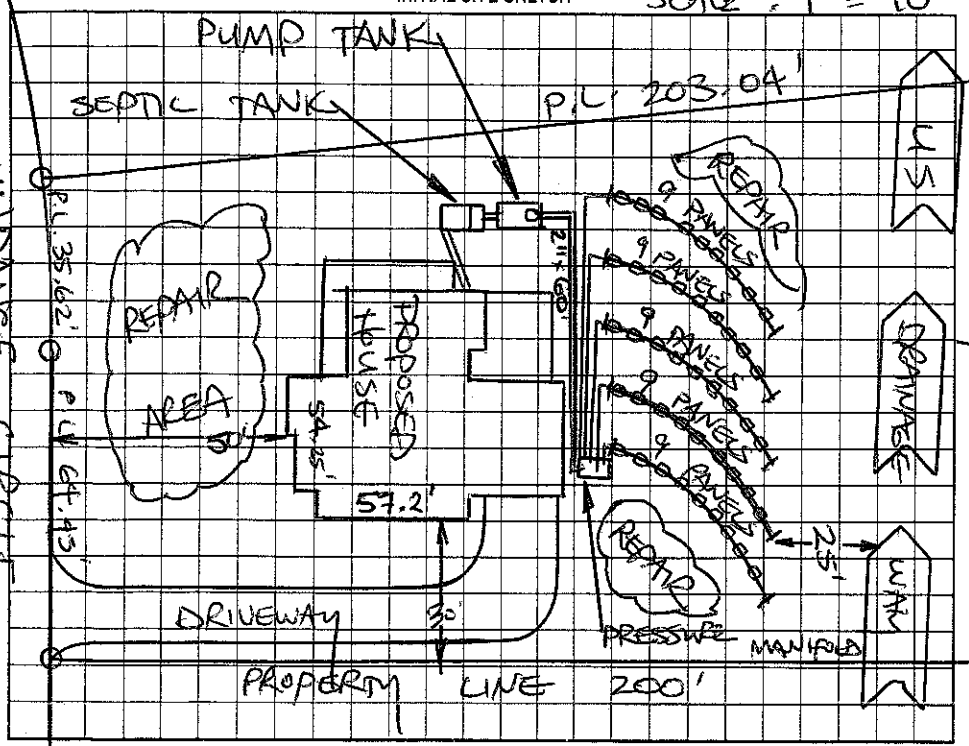

AS BUILT SKETCH

Installed As Shown Per Initial Site Sketch

Permit can be suspended or revoked if any false information is supplied toward securing the permit/any unauthorized changes are made to the site/any unauthorized changes are made in the installation of the system. Improvement Permit with plat valid without expiration. Improvement Permit with site plan valid for sixty months. Authorization to Construct is valid for a period equal to that of Improvement Permit – not to exceed sixty months.

Signed: Charlie Shepherd date 6-11-04 Installed by: Rowan Septic (6/30/04)

Improvement Permit by: STEVE HEDRICK date 6-15-04 Operation Permit by: [signature] date 7/26/04

Authorization to Construct by: STEVE HEDRICK date 6-15-04 Existing System Inspection by: ___ date ___

HEALTH DEPT. COPY: WHITE OWNER COPY (FINAL): YELLOW OWNER COPY (INITIAL): PINK