IREDELL COUNTY HEALTH DEPARTMENT

STATESVILLE 704-878-5305 MOORESVILLE 704-664-5281

IMPROVEMENT PERMIT / AUTHORIZATION TO CONSTRUCT / OPERATION PERMIT / EXISTING SYSTEM INSPECTION

PERMIT# 90572 PIN# 4748128534 PT DATE 9/1/00

OWNER OR CONTRACTOR DIXIELAND INC PHONE: Business 828-478-5331 Home

ADDRESS 154 BETHANY RD. STATESVILLE NC 28625

LOCATION 21N- TL JENNINGS RD- ON LT ~ 2MILES

SUBDIVISION MOUNTAIN BLOOM BLOCK / SECTION 1 LOT 1 LOT AREA 1.65AC SITE CLASS B DESIGN FLOW 360 GAD L.T.A.R. 300 SQ/FT

Septic Tank: 1000 Gallons: STB 825 Date 8/11/00
Pump Tank: Gallons: PT Date
Pump Make: Model Serial No.
Nitrification Field: No Fields 1 Square Feet @ 1200 Linear Feet 400
No Lines 4@100' Trench Width 36" Max Trench Bottom Depth 36" Gravel Depth 12"

☑ New System ☐ Repair System Type: I, (II), III, IV, V, VI
System Description: GRAVITY CONVENTIONAL
Repair System Description: SAME
Maintenance Agreement Required: ☐ Yes ☑ No

☑ House/Mod. Home No. Bedrooms 3
☐ Mobile Home No. Bathrooms 2
☐ Business No. Employees
☐ Other


☐ Slab ☑ Crawl Space ☐ Basement w/plumbing ☐ Basement wo/plumbing

Water Supply: ☑ Individual ☐ Public ☐ Community

Comments:/Conditions:

Comments./Conditions.

INITIAL SITE SKETCH NOT TO SCALE

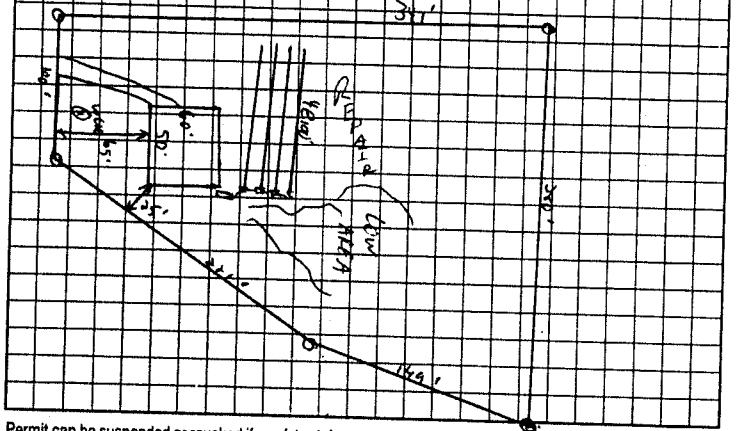

AS BUILT SKETCH

Permit can be suspended or revoked if any false information is supplied toward securing the permit/any unauthorized changes are made to the site/any unauthorized changes are made in the installation of the system. Improvement Permit with plat valid without expiration. Improvement Permit with site plan valid for sixty months. Authorization to Construct is valid for a period equal to that of Improvement Permit – not to exceed sixty months.

Signed: Steven W. Wyatt date 9/5/00 Installed by: Rowan Septic

Improvement Permit by: date 9/1/00 Operation Permit by: date 10/30/00

Authorization to Construct by: date 9/1/00 Existing System Inspection by: date

HEALTH DEPT. COPY: WHITE OWNER COPY (FINAL): YELLOW OWNER COPY (INITIAL): PINK