100

IREDELL COUNTY HEALTH DEPARTMENT

STATESVILLE 704-878-5305 CA MOORESVILLE 704-664-5281 CA

IMPROVEMENT PERMIT / AUTHORIZATION TO CONSTRUCT / OPERATION PERMIT / EXISTING SYSTEM INSPECTION

PERMIT# 143782 PIN# 4748125583 DATE 8-17-07

OWNER OR APPLICANT Regina & Cecil PHONE: Business 704-876-6162 Home

ADDRESS 823 Jennings RD Statesville NC 28625

LOCATION Jennings RD TL Redemption RD 1st Left

SUBDIVISION BLOCK / SECTION LOT LOT AREA 1.19 SITE CLASS. PD DESIGN FLOW 125 L.T.A.R. .25

Septic Tank: 1000 Gallons; STB 825 Date 9-28-07
Pump Tank: Gallons; PT Date
Pump Make: Model Serial No.
Nitrification Field: No Fields Square Feet 500 Linear Feet 132
No Lines 2 Trench Width 36" Max Trench Bottom Depth 36" Gravel Depth AA

☑ New System ☐ Repair ☐ Expansion System Type: I II III IV V VI
System Description: 2570 Gravity
Repair System Description: 2570 Gravity
Maintenance Agreement Required: ☐ Yes ☑ No
☑ Gravity ☐ Pressure ☑ Slab ☐ Crawl Space ☐ Basement w/plumbing ☐ Basement wo/plumbing


☑ House/Mod. Home No. Bedrooms
☐ Mobile Home No. Persons
☐ Business No. Employees 5
☐ Other Building

Water Supply: ☐ Individual ☑ Public ☐ Community


Comments:/Conditions:

Comments:/Conditions:
Install on contour
Maintain all setbacks
Blue Fitter

INITIAL SITE SKETCH

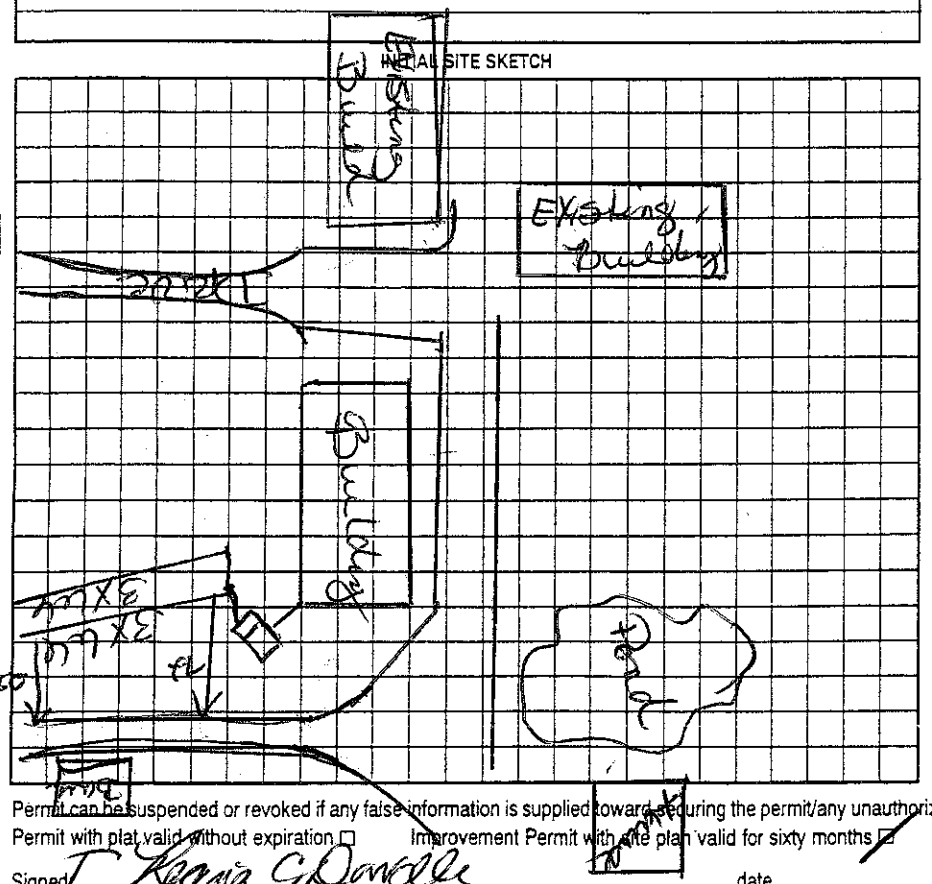

AS BUILT SKETCH

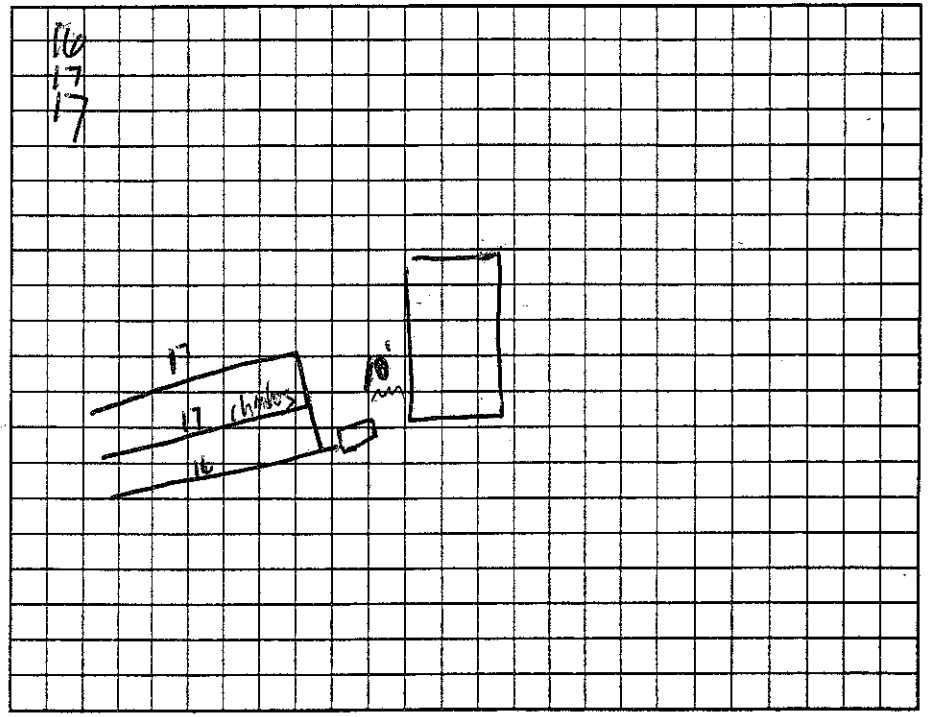

Permit can be suspended or revoked if any false information is supplied toward securing the permit/any unauthorized changes are made to the site/any unauthorized changes are made in the installation of the system. Improvement Permit with plat valid without expiration ☐ Improvement Permit with site plan valid for sixty months ☑ Authorization to Construct is valid for a period equal to that of Improvement Permit – not to exceed sixty months.

Signed Regina C Daniels date

Improvement Permit by: Kelly Cook date 8-17-07

Authorization to Construct by: Kelly Cook date 8-17-07

Installed by: Rowan Septic

Operation Permit by: date 11-9-07

Existing System Inspection by: date

HEALTH DEPT. COPY: WHITE OWNER COPY (FINAL): YELLOW OWNER COPY (INITIAL): PINK