IREDELL COUNTY HEALTH DEPARTMENT

STATESVILLE 704-878-5305 MOORESVILLE 704-664-5281

IMPROVEMENT PERMIT / AUTHORIZATION TO CONSTRUCT / OPERATION PERMIT / EXISTING SYSTEM INSPECTION

PERMIT# Repair PIN# 4748-24-9450 DATE 6-30-04

OWNER OR CONTRACTOR James and Fran Elliott PHONE: Business Home (704) 876-6219

ADDRESS 175 Weston Rd. Statesville, NC 28625

LOCATION 21 N @ Jennings go about 2-3 miles house on left (yellow siding)

SUBDIVISION BLOCK / SECTION LOT LOT AREA 0.55 SITE CLASS. PS DESIGN FLOW 240 L.T.A.R. Existing

Septic Tank: Existing Gallons; STB Date

Pump Tank: Gallons; PT Date

Pump Make: Model Serial No.

Nitrification Field: No Fields 1 Square Feet Linear Feet 100

No Lines 2 Trench Width 36" Max Trench Bottom Depth 36" Gravel Depth 18"

☐ New System ☑ Repair System Type: I (II) III, IV, V, VI

System Description:

Repair System Description: Conventional gravity

Maintenance Agreement Required: ☐ Yes ☑ No

☑ House/Mod. Home No. Bedrooms 2

☐ Mobile Home No. Bathrooms 1

☐ Business No. Employees

☐ Other

☐ Slab ☑ Crawl Space ☐ Basement w/plumbing ☐ Basement wo/plumbing

Water Supply: ☐ Individual ☑ Public ☐ Community Iredell Water


Comments/Conditions: (1) Install new lines on contour (2) ~~Pump, crush and fill~~ Uncover old tank and see if it can still be used - if not pump, crush and fill (3) If tank can still be used, it will require a new tee (4) Disconnect old line if unuseable

Comments/Conditions: (5) This is a 30-day NOV permit to correct this situation before 7-30-04.

(6) Recommend removing trees in front yard, especially red maples.

INITIAL SITE SKETCH

Scale 1" = 50'

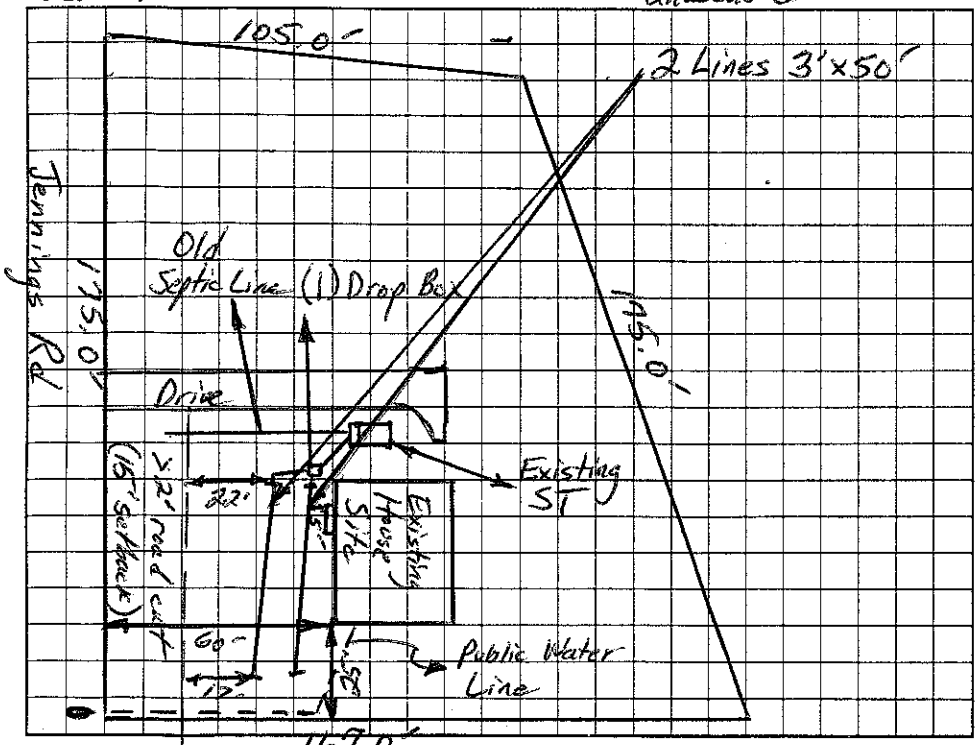

AS BUILT SKETCH


SCALE 1" = 50'

(1) Pumped tank

(2) Installed Blue 'Polylok' filter

(3) Removed red maple tree in front yard

(4) Used ONE 3x50' line w/ 24" stone

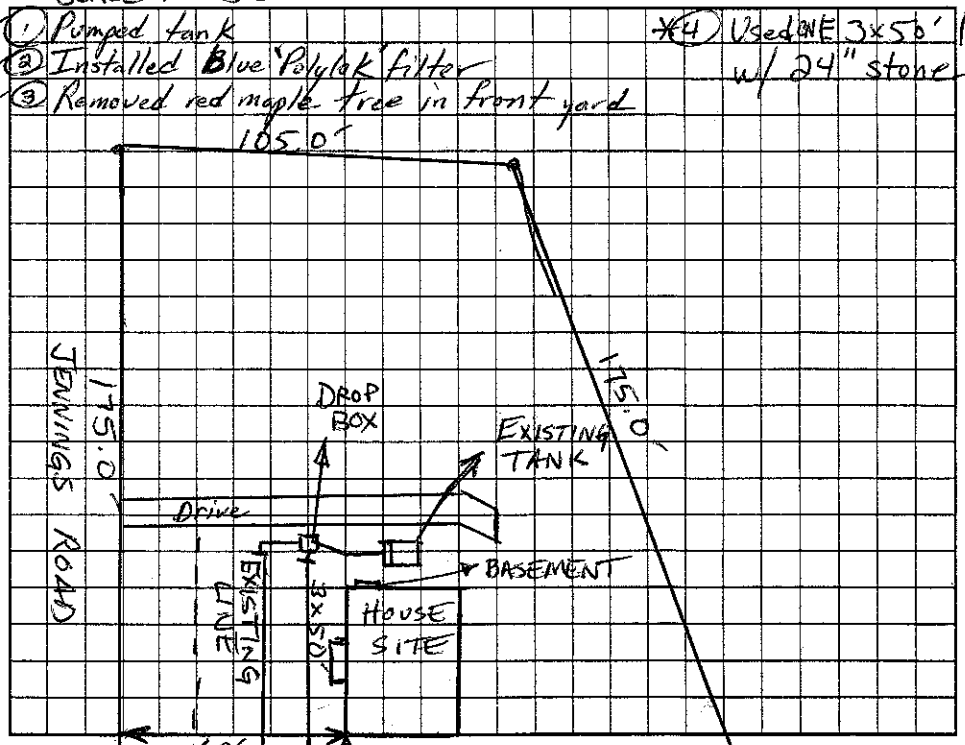

Permit can be suspended or revoked if any false information is supplied toward securing the permit/any unauthorized changes are made to the site/any unauthorized changes are made in the installation of the system. Improvement Permit with plat valid without expiration. Improvement Permit with site plan valid for sixty months. Authorization to Construct is valid for a period equal to that of Improvement Permit – not to exceed sixty months.

Signed: date Installed by:

Improvement Permit by: Christopher M. Shirley RS date 6-30-04 Operation Permit by: Christopher M. Shirley, RS date 7-8-04

Authorization to Construct by: Christopher M. Shirley RS date 6-30-04 Existing System Inspection by: date

HEALTH DEPT. COPY: WHITE OWNER COPY (FINAL): YELLOW OWNER COPY (INITIAL): PINK