IREDELL COUNTY HEALTH DEPARTMENT

STATESVILLE 704-878-5305 MOORESVILLE 704-664-5281

IMPROVEMENT PERMIT / AUTHORIZATION TO CONSTRUCT / OPERATION PERMIT / EXISTING SYSTEM INSPECTION

PERMIT# 132927 PIN# 4748300086 000086 DATE ~~1-4-06~~ 1-4-06

OWNER OR CONTRACTOR Dixieland Construction PHONE: Business 704-202-4971 Home

ADDRESS 823 Jennings Rd Statesville NC 28625

LOCATION 21 W (R) Jennings (R) Deer Gardens (R) Newhaven on left

SUBDIVISION Deer Crossing BLOCK / SECTION 4 LOT 31 LOT AREA .445 SITE CLASS. PS DESIGN FLOW 360 L.T.A.R. 0.3

Septic Tank: 1000 Gallons; STB [illegible] 825 Date 1-20-06

Pump Tank: Gallons; PT Date

Pump Make: Model Serial No.

Nitrification Field: No Fields Square Feet 1200 Linear Feet 300

No Lines 5 Trench Width 36" Max Trench Bottom Depth 36" Gravel Depth NA

☑ New System ☐ Repair System Type: I, (II), III, IV, V, VI

System Description: 25% Gravel

Repair System Description: LPP (50%)

Maintenance Agreement Required: ☐ Yes ☑ No

☐ Slab ☑ Crawl Space ☐ Basement w/plumbing ☐ Basement wo/plumbing

☑ House/Mod. Home No. Bedrooms 3

☐ Mobile Home No. Bathrooms

☐ Business No. Employees


☐ Other

Water Supply:
☐ Individual
☑ Public
☐ Community

Comments:/Conditions:


Comments:/Conditions: Maintain all setbacks. Stay 15' sideslope of Gully. Install on contour.

INITIAL SITE SKETCH

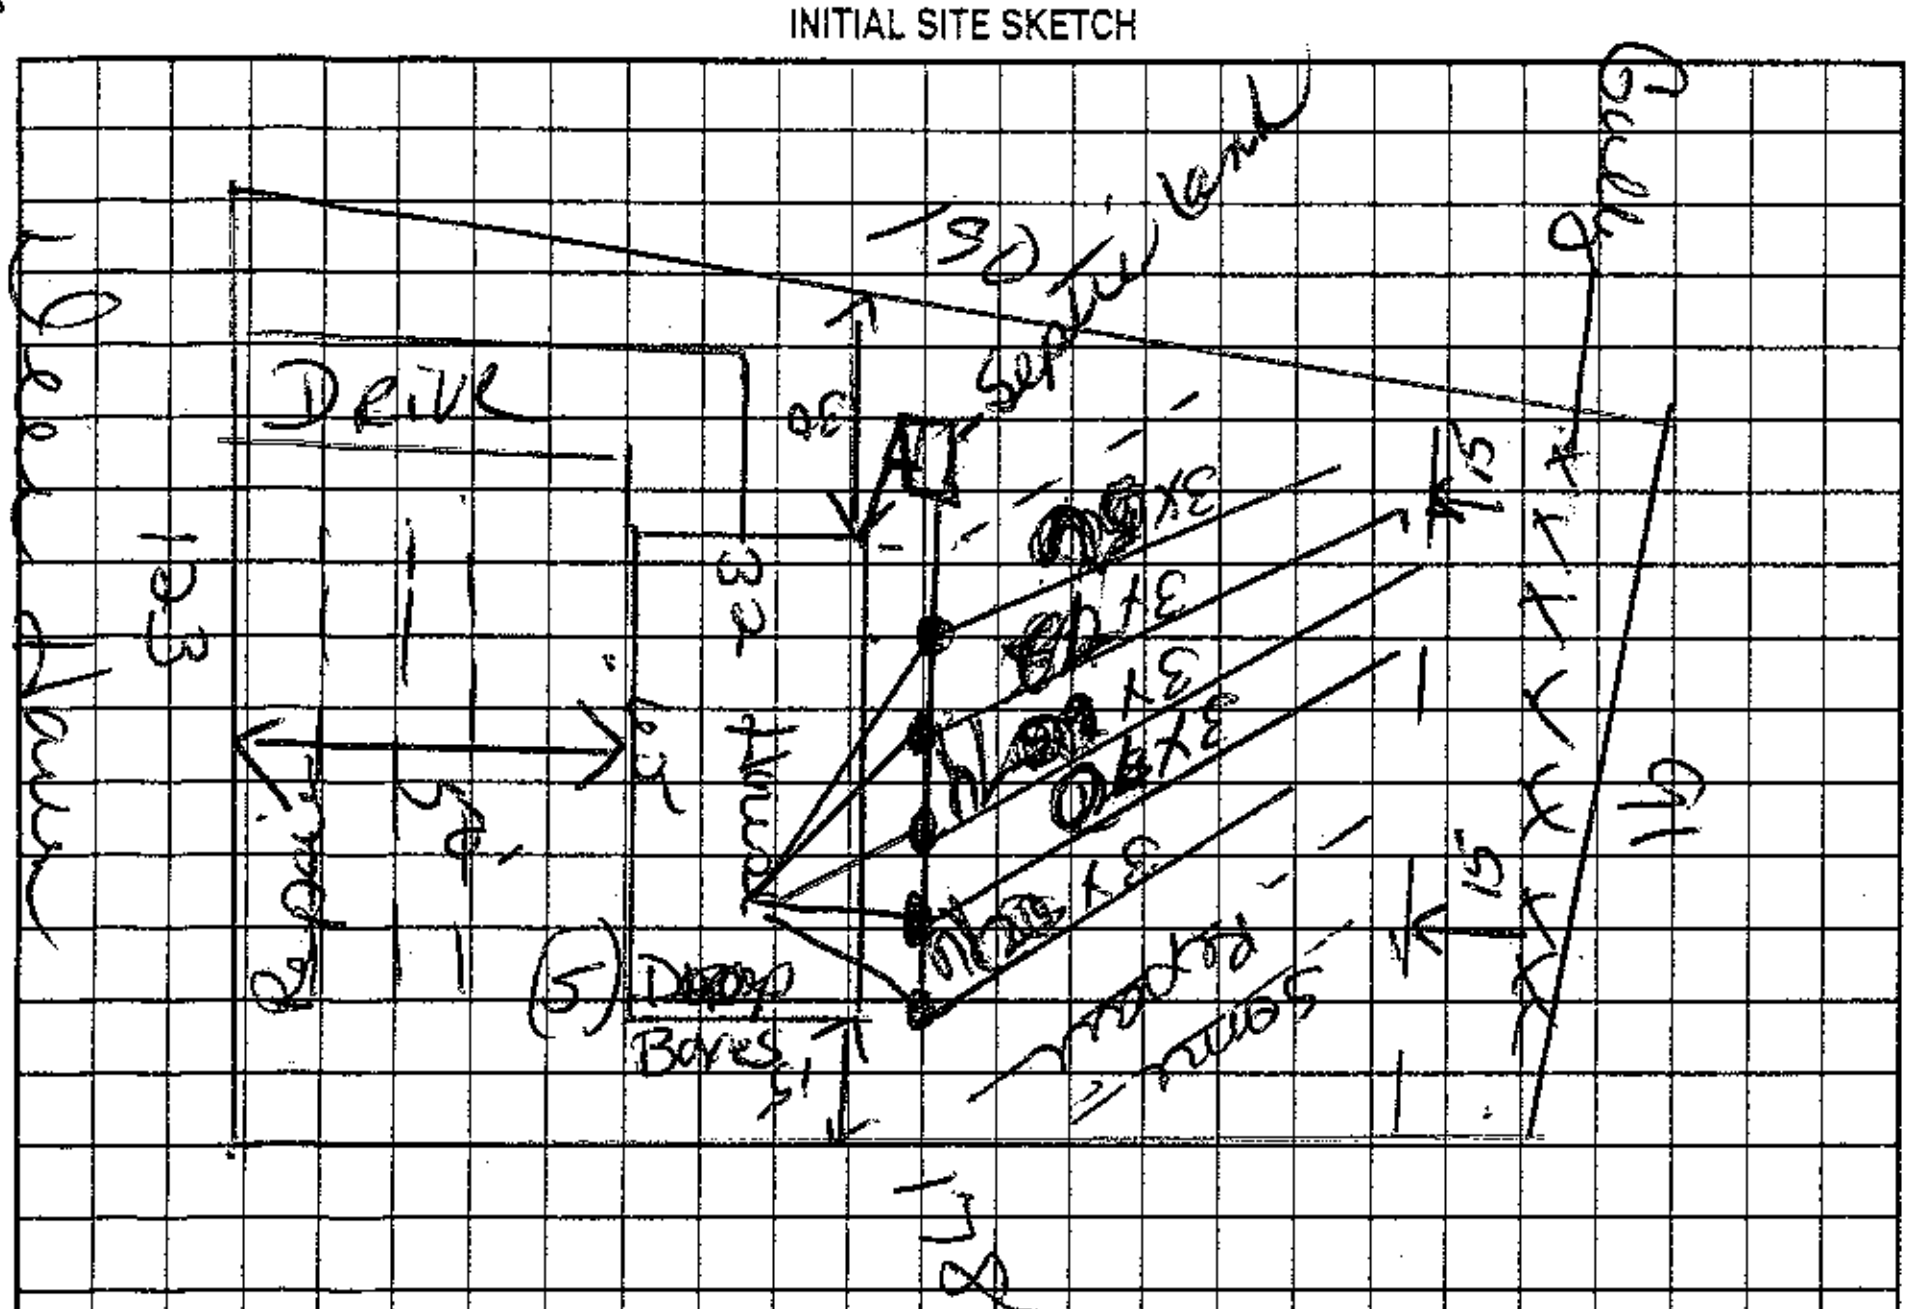

AS BUILT SKETCH

Blue Polylock filter

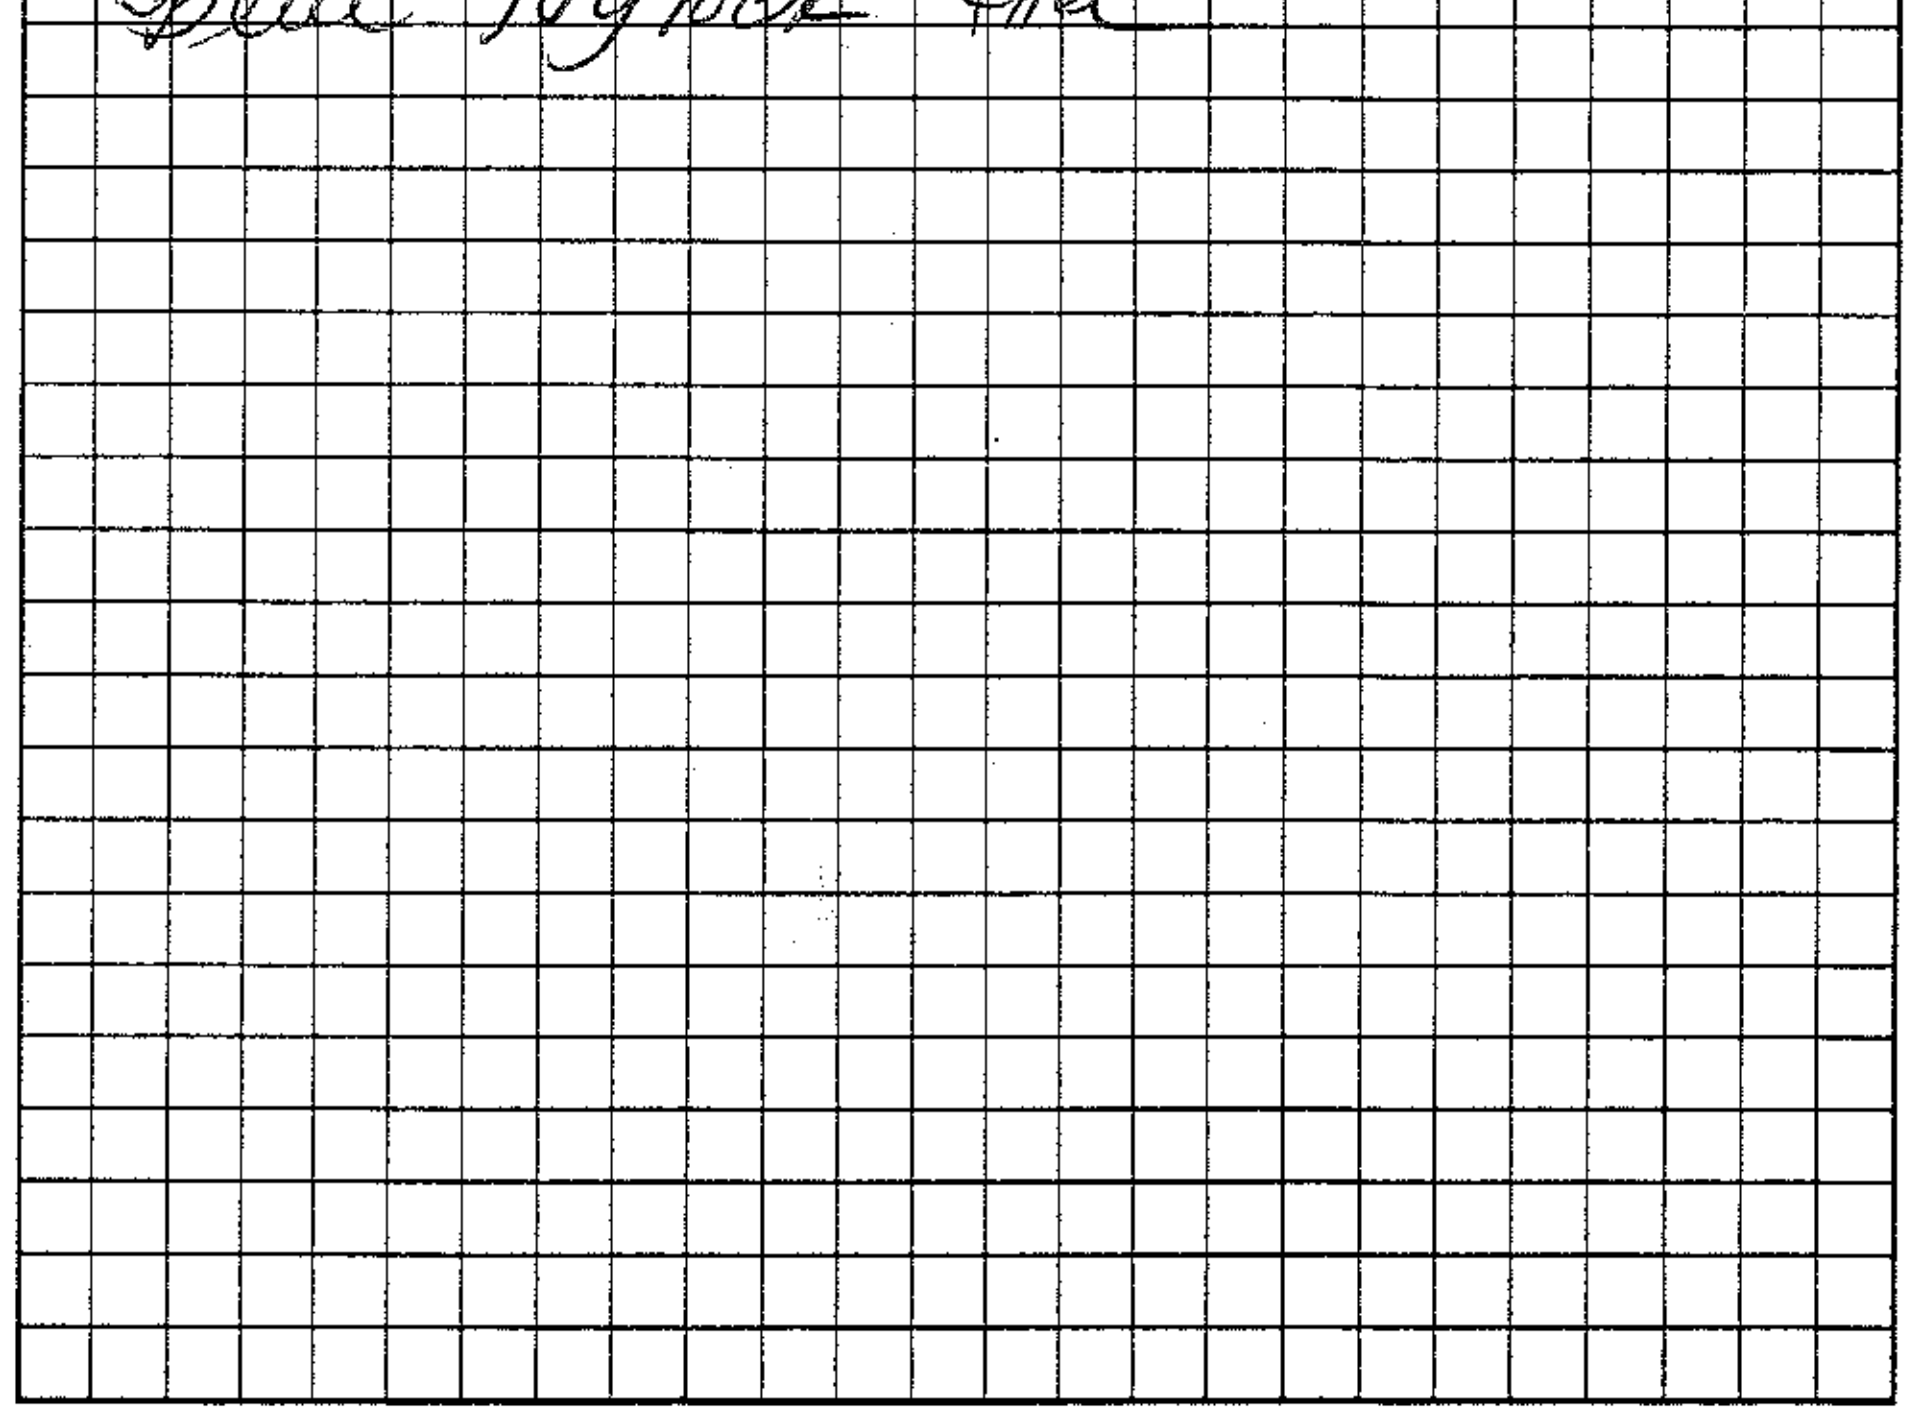

Permit can be suspended or revoked if any false information is supplied toward securing the permit/any unauthorized changes are made to the site/any unauthorized changes are made in the installation of the system. Improvement Permit with plat valid without expiration. Improvement Permit with site plan valid for sixty months. Authorization to Construct is valid for a period equal to that of Improvement Permit – not to exceed sixty months.

Signed: [signature] date 2-10-06 Installed by: Kadan Septic

Improvement Permit by: Kelly Cook date 1-4-06 Operation Permit by: Kelly J Cook date 3-13-06

Authorization to Construct by: Kelly Cook date 1-4-06 Existing System Inspection by: date

HEALTH DEPT. COPY: WHITE OWNER COPY (FINAL): YELLOW OWNER COPY (INITIAL): PINK