IREDELL COUNTY HEALTH DEPARTMENT

THIS PERMIT REPLACES PREVIOUS ISSUED 5-15-04 (A)

STATESVILLE 704-878-5305 MOORESVILLE 704-664-5281

IMPROVEMENT PERMIT / AUTHORIZATION TO CONSTRUCT / OPERATION PERMIT / EXISTING SYSTEM INSPECTION

PERMIT# 114887 PIN# 4748-30-1098 DATE 8-10-04

OWNER OR CONTRACTOR DIXIELAND, INC. PHONE: Business 704-202-4971 Home 704-876-6162

ADDRESS 823 JENNINGS ROAD, STATESVILLE NC 28625

LOCATION US 21 NORTH, TL JENNINGS RD TL DEER HAVEN DRIVE, LOT # 32 ON LEFT (3RD PAST SUNDANCE)

SUBDIVISION DEER CROSSING BLOCK / SECTION 4 LOT 32 LOT AREA 0.4591 ACRE SITE CLASS. PS DESIGN FLOW 360 L.T.A.R. 0.3 GPD/FT²

Septic Tank: 1000 Gallons; STB 825 Date 7-21-04

Pump Tank: _____ Gallons; PT _____ Date _____

Pump Make: _____ Model _____ Serial No. _____

Nitrification Field: No Fields 1 Square Feet EQ. TO 1200 Linear Feet 200

No Lines FOUR Trench Width 24" Max Trench Bottom Depth 36" ~~Stone~~ Depth SAND 24"

☑ New System ☐ Repair System Type: I, II, (III), IV, V, VI

System Description: 50% REDUCTION, GRAVITY

Repair System Description: 50% REDUCTION, LOW PRESSURE

Maintenance Agreement Required: ☐ Yes ☑ No

☑ House/Mod. Home No. Bedrooms 3

☐ Mobile Home No. Bathrooms 2

☐ Business No. Employees ____

☐ Other ____


☐ Slab ☑ Crawl Space ☐ Basement w/plumbing ☐ Basement wo/plumbing

Water Supply: ☐ Individual ☑ Public ☐ Community

Comments:/Conditions: INSTALL 50% REDUCTION SYSTEM USING 48 PPBPS PANELS WITH THREE FLOW DIVIDER TEES (AS SHOWN (OR ONE "TRU-FLOW" EFFLUENT SPLITTER) TO ACHIEVE EQUAL DISTRIBUTION.

Comments:/Conditions: SEPTIC TANK WITH MARKER INSTALLED USING A "POLYLOK" FILTER

INITIAL SITE SKETCH

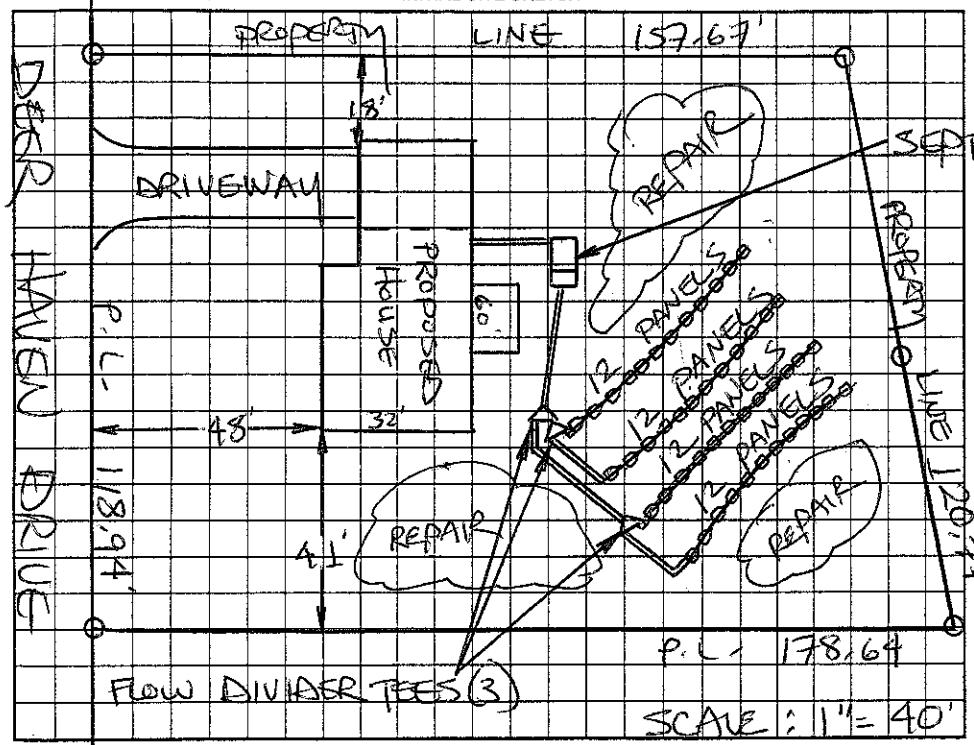

AS BUILT SKETCH

SYSTEM INSTALLED ACCORDING TO INITIAL SITE SKETCH

Permit can be suspended or revoked if any false information is supplied toward securing the permit/any unauthorized changes are made to the site/any unauthorized changes are made in the installation of the system. Improvement Permit with plat valid without expiration. Improvement Permit with site plan valid for sixty months. Authorization to Construct is valid for a period equal to that of Improvement Permit – not to exceed sixty months.

Signed: Georgia Cecil date 8/10/04

Improvement Permit by: STEVE HEDRICK date 8.10.04

Authorization to Construct by: STEVE HEDRICK date 8-10-04

Installed by: ROWAN SEPTIC

Operation Permit by: STEVE HEDRICK date 10-6-04

Existing System Inspection by: _____ date _____

HEALTH DEPT. COPY: WHITE OWNER COPY (FINAL): YELLOW OWNER COPY (INITIAL): PINK