IREDELL COUNTY HEALTH DEPARTMENT

STATESVILLE 704-878-5305 130.00 Paid MOORESVILLE 704-664-5281

IMPROVEMENT PERMIT / AUTHORIZATION TO CONSTRUCT / OPERATION PERMIT / EXISTING SYSTEM INSPECTION

PERMIT# 114907 PIN# 4747-~~39-1486.34~~ 304260 DATE April 21, 05

OWNER OR CONTRACTOR Overland Tire PHONE: Business Home

ADDRESS 623 Jennings Rd. Statesville N.C. 28625

LOCATION US 21 N - TL Jennings Rd. TL Deer Haven Dr. on left at jct. w/ Sundance Circle

SUBDIVISION Deer Crossing BLOCK / SECTION IV LOT 34 LOT AREA .459 Ac SITE CLASS. PS DESIGN FLOW 360 gpd L.T.A.R. .3

Septic Tank: 1000 Gallons; STB 825 Date 2/25/05
Pump Tank: 1000 Gallons; PT 302 Date 4/7/05
Pump Make: Zoeller Model N137 Serial No.
Nitrification Field: No Fields 1 Square Feet 900 Linear Feet 300
No Lines 6@50' Trench Width 36" Max Trench Bottom Depth 36" Gravel Depth N/A

☑ New System ☐ Repair System Type: I, II, III, IV, V, VI
System Description: pm 25% Reduction
Repair System Description: LPPBPS
Maintenance Agreement Required: ☐ Yes ☑ No Initially

☒ House/Mod. Home No. Bedrooms 3
☐ Mobile Home No. Bathrooms
☐ Business No. Employees
☐ Other

☐ Slab ☒ Crawl Space ☐ Basement w/plumbing ☐ Basement wo/plumbing

Water Supply:
☐ Individual
☒ Public
☐ Community


Comments:/Conditions:

Pump specs: 50gal/min @ 26' TDH

Comments:/Conditions: ST w/ marker Poly-Lok Filter
System installed as drawn

1"=50'

INITIAL SITE SKETCH

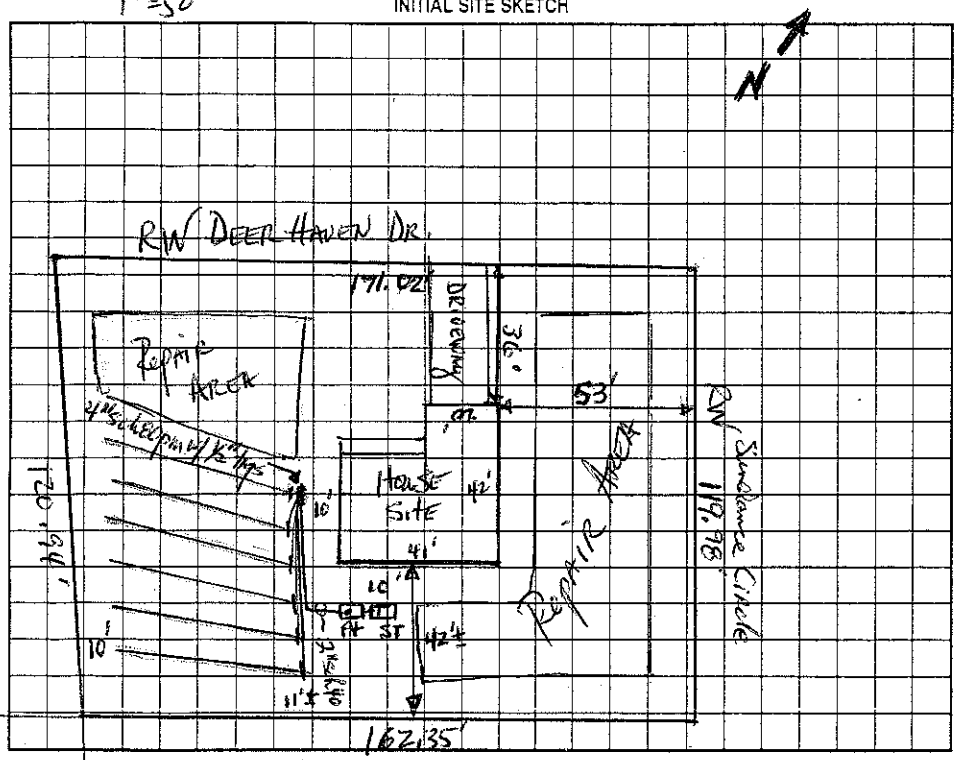

AS BUILT SKETCH

System installed according to initial site sketch

Permit can be suspended or revoked if any false information is supplied toward securing the permit/any unauthorized changes are made to the site/any unauthorized changes are made in the installation of the system. Improvement Permit with plat valid without expiration. Improvement Permit with site plan valid for sixty months. Authorization to Construct is valid for a period equal to that of Improvement Permit – not to exceed sixty months.

Signed: Regina Reece date 4/28/05 Installed by: Rowan Septic

Improvement Permit by: date 4-21-05 Operation Permit by: Steve Hedrick date 10-12-05

Authorization to Construct by: date 4-21-05 Existing System Inspection by: date

HEALTH DEPT. COPY: WHITE OWNER COPY (FINAL): YELLOW OWNER COPY (INITIAL): PINK