IREDELL COUNTY HEALTH DEPARTMENT

STATESVILLE 704-878-5305 MOORESVILLE 704-664-5281

IMPROVEMENT PERMIT / AUTHORIZATION TO CONSTRUCT / OPERATION PERMIT / EXISTING SYSTEM INSPECTION

1320 Fad C

PERMIT# 114854 PIN# 4748 30 5496 DATE August 17, 05

OWNER OR CONTRACTOR Dixieland Inc. PHONE: Business (704) 876-6162 Home

ADDRESS 823 Jennings Rd., Statesville, N.C. 28625

LOCATION US 21(N) TL Jennings Rd. TL Deer Haven Dr. Approx 300' on Right

SUBDIVISION Deer Crossing BLOCK / SECTION IV LOT 14 LOT AREA .45AC SITE CLASS. B DESIGN FLOW 360gpd L.T.A.R. N.3

Septic Tank: 1000 Gallons; STB 325 Date 8-14-05

Pump Tank: Gallons; PT Date

Pump Make: Model Serial No.

Nitrification Field: No Fields 1 Square Feet 400/600 Linear Feet 200

No Lines 4@50' Trench Width 24" min 36" Max Trench Bottom Depth 36"

☒ New System ☐ Repair System Type: I, II, III, IV, V, VI

System Description: Gravity PPBPS

Repair System Description: 1 PPBPS

Maintenance Agreement Required: ☐ Yes ☒ No Initially

☒ House/Mod. Home No. Bedrooms 3

☐ Mobile Home No. Bathrooms

☐ Business No. Employees

☐ Other


Water Supply: ☐ Individual ☒ Public ☐ Community

Gravel Depth N/A ☐ Slab ☒ Crawl Space ☐ Basement w/plumbing ☐ Basement wo/plumbing

Comments/Conditions: DO NOT cut AREA behind house & Backfill as needed to provide positive drainage.

Comments/Conditions: Blue Polylock fittings installed

1"=50' INITIAL SITE SKETCH

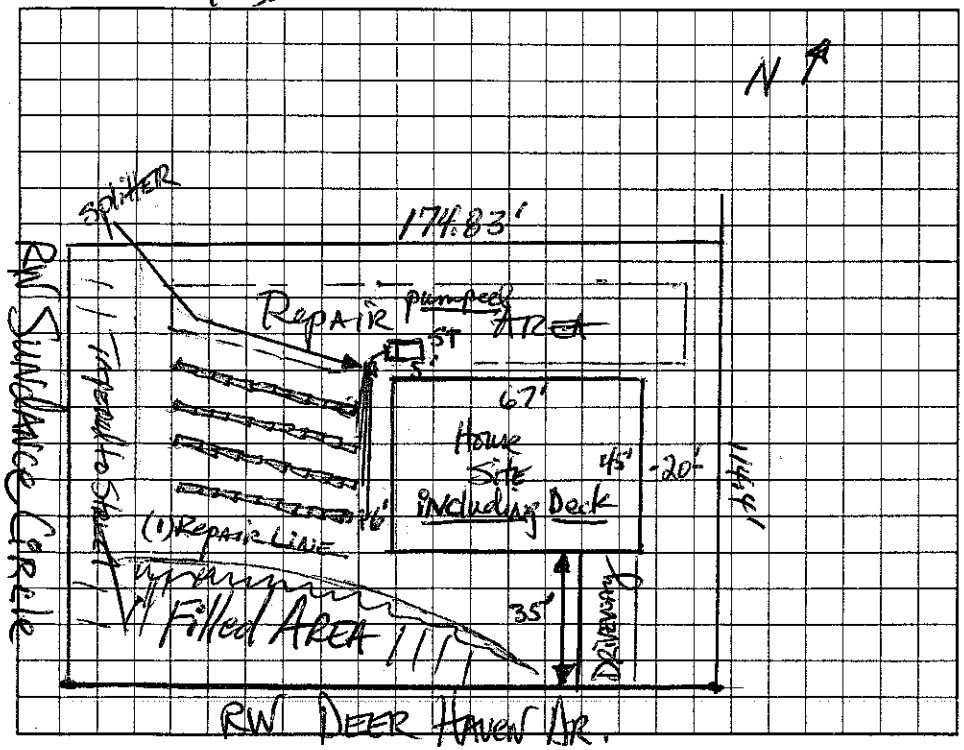

AS BUILT SKETCH

Permit can be suspended or revoked if any false information is supplied toward securing the permit/any unauthorized changes are made to the site/any unauthorized changes are made in the installation of the system. Improvement Permit with plat valid without expiration. Improvement Permit with site plan valid for sixty months. Authorization to Construct is valid for a period equal to that of Improvement Permit – not to exceed sixty months.

Signed: Kenneth Cook date 8/24/05 Installed by: Rowan Septic

Improvement Permit by: DH Moore, RS date 8-17-05 Operation Permit by: Kelly Cook date 10-26-05

Authorization to Construct by: DH Moore, RS date 8-17-05 Existing System Inspection by: date

HEALTH DEPT. COPY: WHITE OWNER COPY (FINAL): YELLOW OWNER COPY (INITIAL): PINK