# IREDELL COUNTY HEALTH DEPARTMENT

STATESVILLE 704-878-5305 130.00 Paid MOORESVILLE 704-664-5281

## IMPROVEMENT PERMIT / AUTHORIZATION TO CONSTRUCT / OPERATION PERMIT / EXISTING SYSTEM INSPECTION

PERMIT# 120077 PIN# ~~4749-39-7986.72~~ 4748-30-5515 DATE April 26, 04

OWNER OR CONTRACTOR Dixieland Inc. PHONE: Business _____ Home _____

ADDRESS 623 Jennings Rd, Statesville, N.C. 28625

LOCATION I-5 21 N. TL Jennings Rd. TL Deer Haven TR Sundance Circle 2nd lot on Right

SUBDIVISION Deer Crossing BLOCK / SECTION IV LOT 72 LOT AREA .479 Ac SITE CLASS PS DESIGN FLOW 360 gpd L.T.A.R. <3

Septic Tank: 1000 Gallons; STB 825 Date 11-16-04
Pump Tank: 1000 Gallons; PT 302 Date A-10-05
Pump Make: Zoeller Model N-152 Serial No. _____
Nitrification Field: No Fields 1 Square Feet 900 Linear Feet 300
No Lines 4 Trench Width 36" Max Trench Bottom Depth 36" Gravel Depth NA

☑ New System ☐ Repair System Type: I, II, III, IV, V, VI
System Description: PM-25% Reduction
Repair System Description: LPPBPS
Maintenance Agreement Required: ☐ Yes ☑ No Initially

☑ House/Mod. Home No. Bedrooms 3
☐ Mobile Home No. Bathrooms 2
☐ Business No. Employees _____
☐ Other _____
☐ Slab ☑ Crawl Space ☐ Basement w/plumbing ☐ Basement wo/plumbing


Water Supply:
☐ Individual
☑ Public
☐ Community

Comments:/Conditions:

Comments:/Conditions: SEPTIC TANK WITH MARKER INSTALLED USING "POLY LOK" FILTER

1"=50'

INITIAL SITE SKETCH

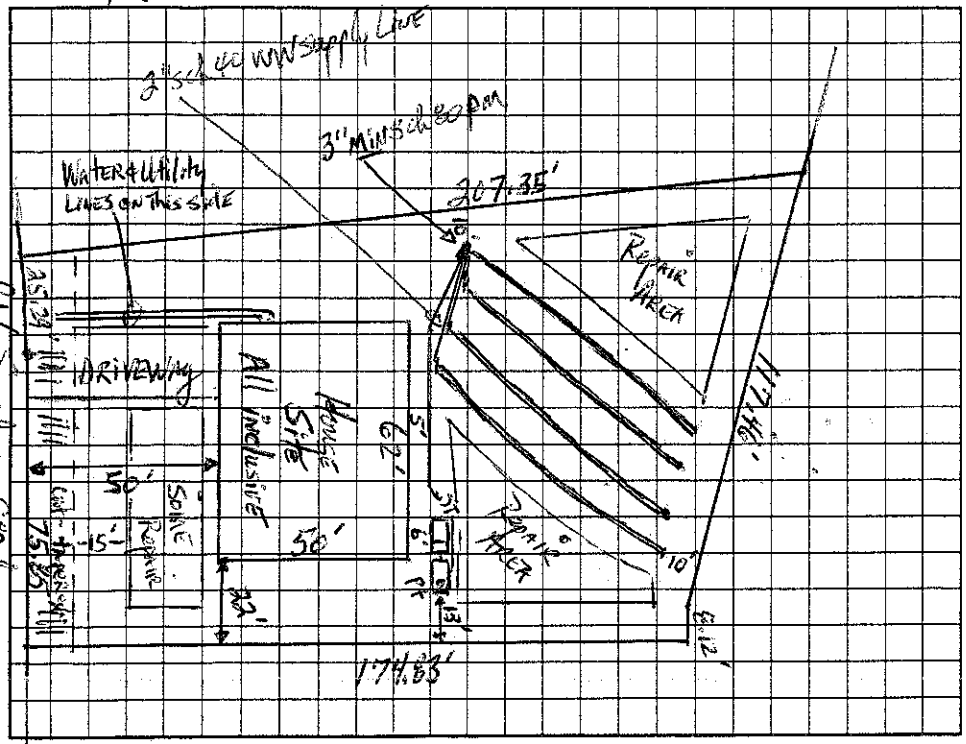


AS BUILT SKETCH

SYSTEM INSTALLED ACCORDING TO INITIAL SITE SKETCH USING 75 "QUICK-4" INFILTRATOR CHAMBERS

Permit can be suspended or revoked if any false information is supplied toward securing the permit/any unauthorized changes are made to the site/any unauthorized changes are made in the installation of the system. Improvement Permit with plat valid without expiration. Improvement Permit with site plan valid for sixty months. Authorization to Construct is valid for a period equal to that of Improvement Permit – not to exceed sixty months.

Signed: Jaye Garrison date 4/30/04 Installed by: Rowan Septic

Improvement Permit by: D.W. Hunter, RS date 4-26-04 Operation Permit by: Steve Hedrick date 6-30-05

Authorization to Construct by: Steve Hedrick date 12-14-04 Existing System Inspection by: _____ date _____

HEALTH DEPT. COPY: WHITE OWNER COPY (FINAL): YELLOW OWNER COPY (INITIAL): PINK