IREDELL COUNTY HEALTH DEPARTMENT

STATESVILLE 704-878-5305 #130 MOORESVILLE 704-664-5281

IMPROVEMENT PERMIT / AUTHORIZATION TO CONSTRUCT / OPERATION PERMIT / EXISTING SYSTEM INSPECTION

PERMIT# 112778 PIN# ~~4748-20-8265.5~~ 4748-30-6678 DATE Sept 8, 03

OWNER OR CONTRACTOR Dixie Build Inc PHONE: Business _____ Home _____

ADDRESS 823 Jennings Rd. Statesville, N.C. 28625

LOCATION 21N TL Jennings Rd. on left past Spud Lane & before Sunswept L/p.

SUBDIVISION Deer Crossing BLOCK / SECTION 1 LOT 3 LOT AREA 4893 Ac SITE CLASS. BI DESIGN FLOW 360gpd L.T.A.R. .3

Septic Tank: 1000 Gallons: STB 525 Date 12-18-03
Pump Tank: 1000 Gallons: PT 302 Date 12-9-03
Pump Make: Zoeller Model N137 Serial No. _____
Nitrification Field: No Fields 1 Square Feet 900 Linear Feet 300
No Lines 4 Trench Width 36" Max Trench Bottom Depth 36" Gravel Depth N/A

☑ New System ☐ Repair System Type: I, II, III, IV, V, VI
System Description: pin - 25% Reduction
Repair System Description: pin lip 25-50% Reduction
Maintenance Agreement Required: ☐ Yes ☑ No Initially

☑ House/Mod. Home No. Bedrooms 3
☐ Mobile Home No. Bathrooms 2
☐ Business No. Employees _____
☐ Other _____

☐ Slab ☑ Crawl Space ☐ Basement w/plumbing ☐ Basement wo/plumbing

Water Supply: ☐ Individual ☑ Public ☐ Community


Comments:/Conditions: Do not cut around house!

Pump specs: 36gal/min @ 25' TDH

Comments:/Conditions: SEPTIC TANK WITH MARKER INSTALLED USING "POLY LOK" FILTER. DRAINLINES INSPECTED & PRESSURE-CHECKED 2-25-04, FSH

1"=50'

INITIAL SITE SKETCH

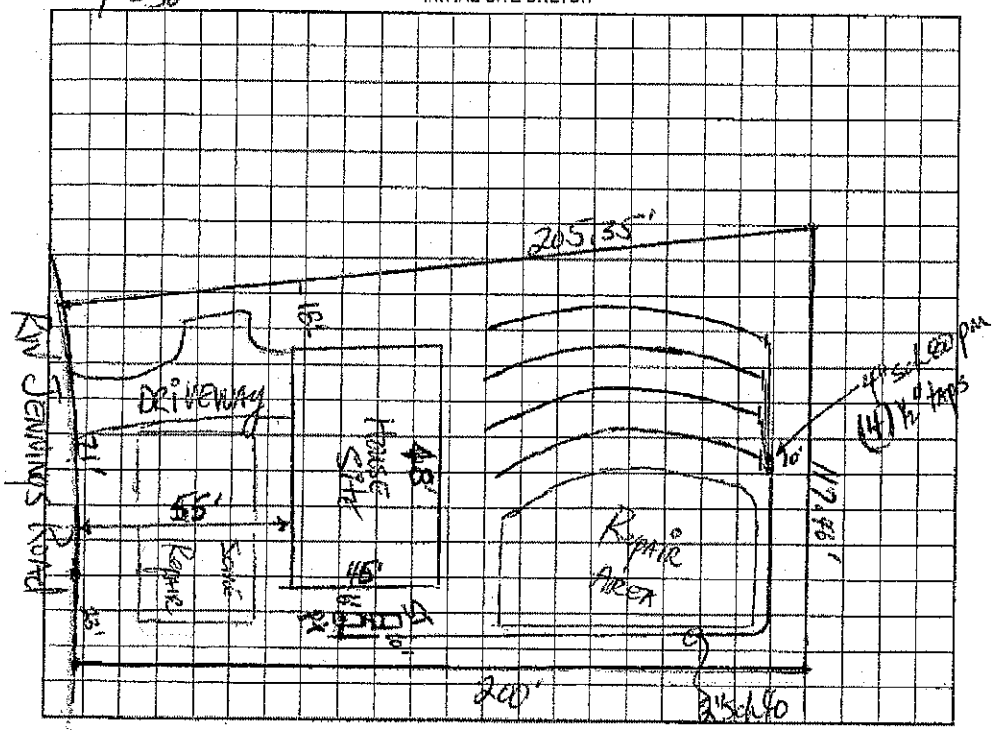

AS BUILT SKETCH

SYSTEM INSTALLED According to INITIAL SITE SKETCH

Permit can be suspended or revoked if any false information is supplied toward securing the permit/any unauthorized changes are made to the site/any unauthorized changes are made in the installation of the system. Improvement Permit with plat valid without expiration. Improvement Permit with site plan valid for sixty months. Authorization to Construct is valid for a period equal to that of Improvement Permit – not to exceed sixty months.

Signed: Regina Gee date 9/29/03

Improvement Permit by: Harold Lyons, REHS date 9-8-03

Authorization to Construct by: Steve Hedrick date 11-7-03

Installed by: Rowan Septic Tank

Operation Permit by: Steve Hedrick date 6-17-04

Existing System Inspection by: _____ date _____

HEALTH DEPT. COPY: WHITE OWNER COPY (FINAL): YELLOW OWNER COPY (INITIAL): PINK