IREDELL COUNTY HEALTH DEPARTMENT

STATESVILLE 704-878-5305 #130 MOORESVILLE 704-664-5281

IMPROVEMENT PERMIT / AUTHORIZATION TO CONSTRUCT / OPERATION PERMIT / EXISTING SYSTEM INSPECTION

PERMIT# 12778 PIN# ~~4748-20-8265.5~~ 4748-30-6678 DATE Sept 8, 03

OWNER OR CONTRACTOR Dixieland Inc PHONE: Business Home

ADDRESS 823 Jennings Rd. Statesville, N.C. 28625

LOCATION 21N TL Jennings Rd. on left past Spud Lane & before Sunswept Lp.

SUBDIVISION Deer Crossing BLOCK / SECTION 1 LOT 3 LOT AREA 5.4893 Ac SITE CLASS. B1 DESIGN FLOW 360 gpd L.T.A.R. .3

Septic Tank: 1000 Gallons; STB $25 Date 12-18-03

Pump Tank: 1000 Gallons; PT 302 Date 1-9-03

Pump Make: Zoeller Model N137 Serial No.

Nitrification Field: No Fields 1 Square Feet 900 Linear Feet 300

No Lines 4 Trench Width 36" Max Trench Bottom Depth 36"

☑ New System ☐ Repair System Type: I, II, III, IV, V, VI

System Description: PIN - 25% Reduction

Repair System Description: PIN per LP 25-50% Reduction

Maintenance Agreement Required: ☐ Yes ☑ No Initially

☑ House/Mod. Home No. Bedrooms 3

☐ Mobile Home No. Bathrooms 2

☐ Business No. Employees

☐ Other

☐ Slab ☑ Crawl Space ☐ Basement w/plumbing ☐ Basement wo/plumbing

Water Supply: ☐ Individual ☑ Public ☐ Community


Comments:/Conditions: Do not cut Around house!

Pump Specs: 36 gal/min @ 25' TDH

Comments:/Conditions: SEPTIC TANK WITH MARKER INSTALLED USING "POLYLOK" FILTER. DRAINLINES INSPECTED & PRESSURE CHECKED 2-25-04, FSH

1" = 50'

INITIAL SITE SKETCH

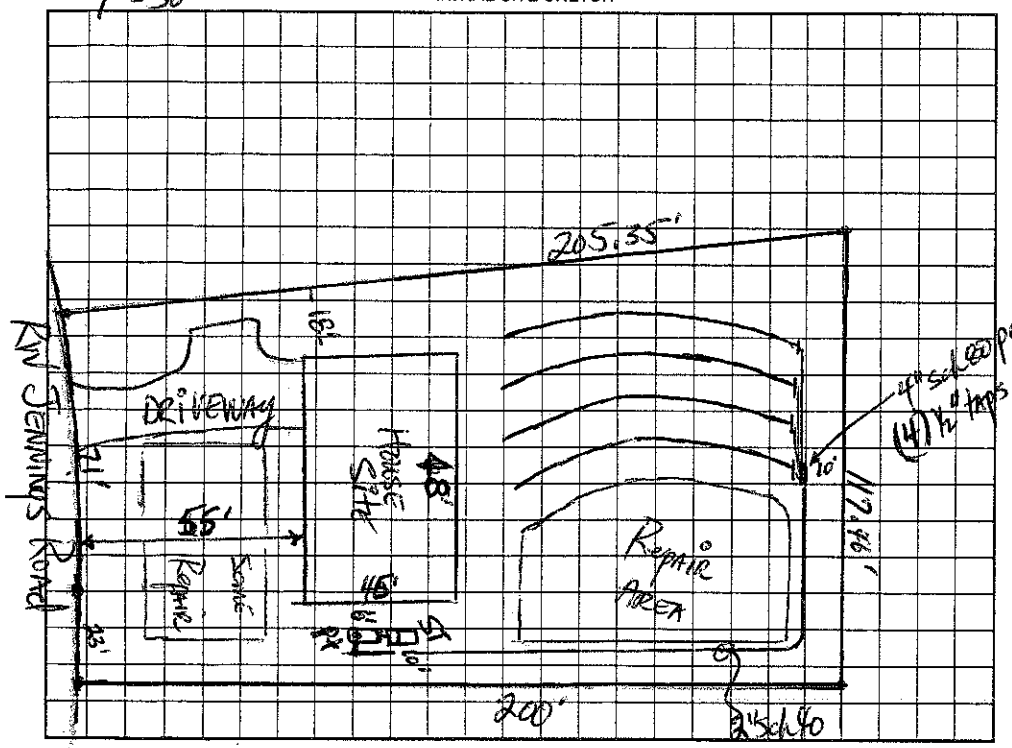

AS BUILT SKETCH

SYSTEM INSTALLED ACCORDING TO INITIAL SITE SKETCH

Permit can be suspended or revoked if any false information is supplied toward securing the permit/any unauthorized changes are made to the site/any unauthorized changes are made in the installation of the system. Improvement Permit with plat valid without expiration. Improvement Permit with site plan valid for sixty months. Authorization to Construct is valid for a period equal to that of Improvement Permit – not to exceed sixty months.

Signed: Regina Gray date 9/29/03

Improvement Permit by: Hendrick, RS date 9-8-03

Authorization to Construct by: Steve Hedrick date 11-7-03

Installed by: Rowan Septic Tank

Operation Permit by: Steve Hedrick date 6-17-04

Existing System Inspection by: date

HEALTH DEPT. COPY: WHITE OWNER COPY (FINAL): YELLOW OWNER COPY (INITIAL): PINK