IREDELL COUNTY HEALTH DEPARTMENT

Statesville Office (704) 878-5305 Mooresville Office (704) 660-3625 PERMIT # 210295

IMPROVEMENT PERMIT / AUTHORIZATION TO CONSTRUCT / OPERATION PERMIT / EXISTING SYSTEM

PIN # 4749306678

APPLICANT: Blackburn Enterprises APPLICANT ADDRESS: 2581 Penngate Drive

SITE ADDRESS: 745 Jennings Rd PHONE: 784-451-3398 ALT. PHONE: N/A

SITE DIRECTIONS: Hwy 21N TL Jennings Rd Property on Left

SUBDIVISION: Deer Crossing SECTION: P1 LOT # 3 LOT AREA: 0.489 acres DESIGN FLOW: 360gld L.T.A.R.: Existing


Septic Tank	Existing (gal)	STB	Date	☐ New System ☐ Repair ☐ Expansion System Type: I II (III) IV V VI	☑ Residence	No. Bedrooms	3	Water Supply	
Pump Tank	(gal)	PT	Date	System Description: 25% Reduction - Pump	☐ Business	No. Persons	6	☐ Private	
Pump Make	Model		Serial #	Repair System Description:	☐ Other	No. Employees		☑ Public	
# Nitrification Fields	Ex # Lines Ex		Linear Ft: Ex	Maintenance Agreement Required: ☐ YES ☑ NO	☐ Slab	☑ Crawl Space		☐ Community	
Trench Width	Ex Max. Trench Bottom Depth Ex		Gravel Depth Ex	☐ GRAVITY ☑ PRESSURE	☐ Basement w/plumbing			☐ Basement w/o plumbing	

Comments / Conditions:

- Maintain a minimum of 5' between Deck Foundation & all components of septic tank system.

INITIAL SITE SKETCH

AS BUILT SKETCH

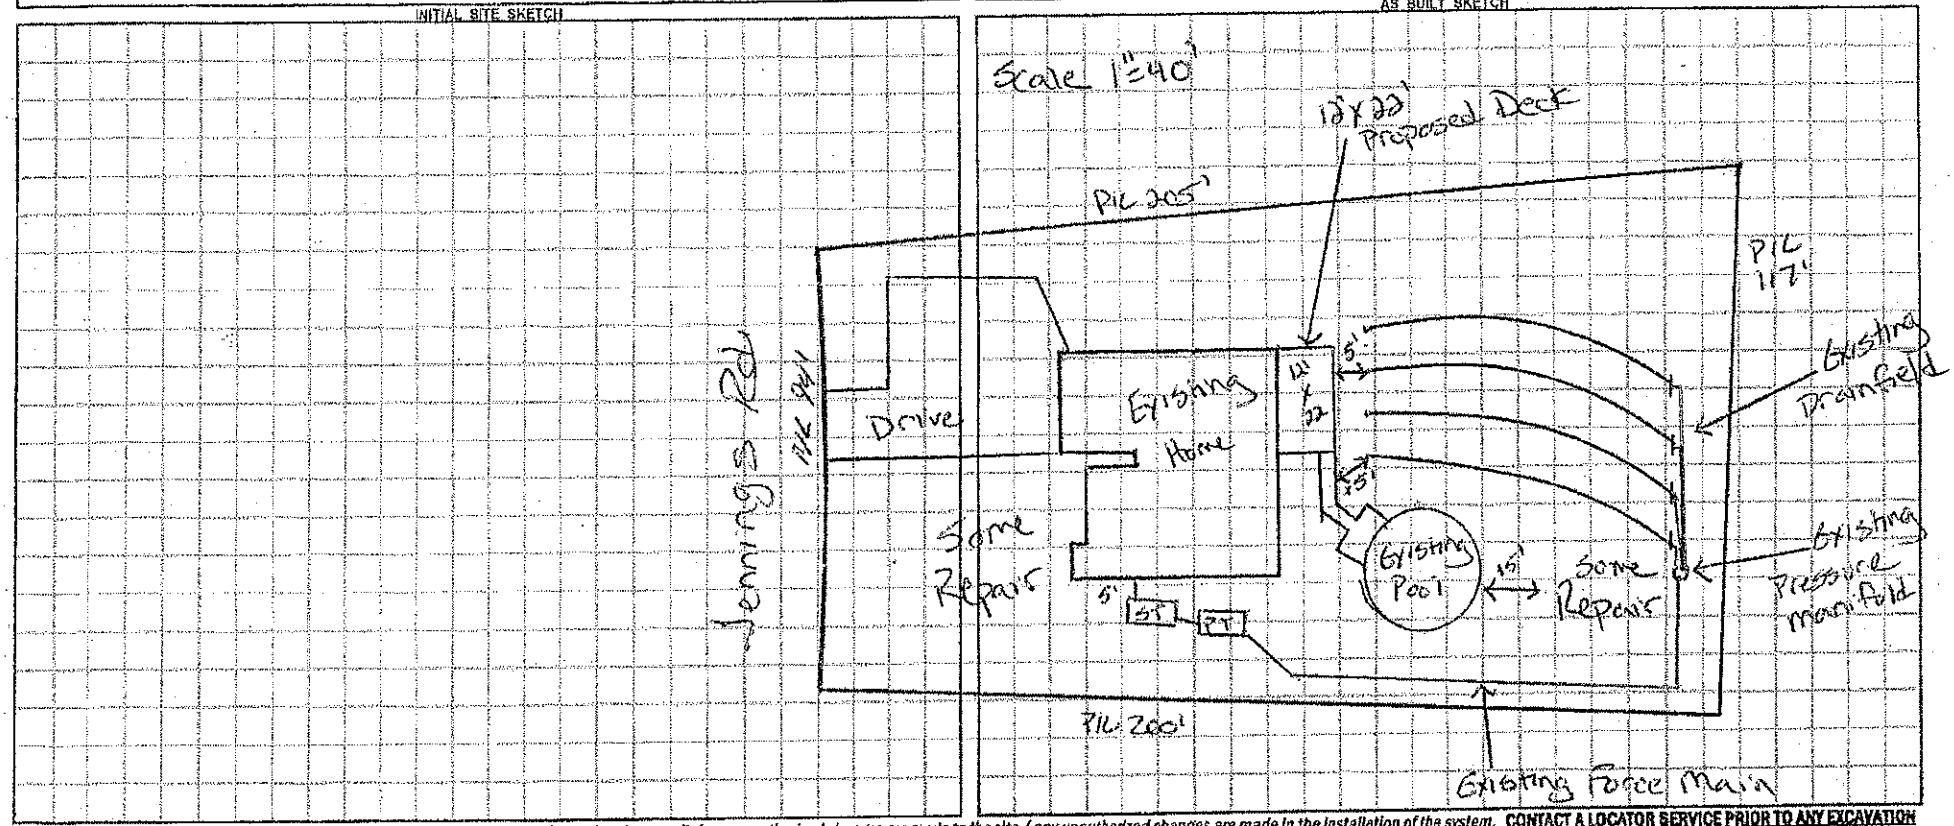

Permit can be suspended or revoked if any false information is supplied toward securing the permit / any unauthorized changes are made to the site / any unauthorized changes are made in the installation of the system. **CONTACT A LOCATOR SERVICE PRIOR TO ANY EXCAVATION**

☐ **IMPROVEMENT PERMIT** *with plat valid without expiration.* ☐ **IMPROVEMENT PERMIT** *with site plan valid for 60 mos.* ☐ **AUTHORIZATION TO CONSTRUCT** *valid for period equal to IMPROVEMENT PERMIT--not to exceed 60 mo.*

Owner / Applicant Signature: [signature] Date: 6/3/15 Installed by:

IMPROVEMENT PERMIT by: Date: OPERATION PERMIT by: Date:

AUTHORIZATION TO CONSTRUCT by: Date: Existing System Inspected by: Justin Henderson Date: 6-3-15

Health Dept. Copy - WHITE Applicant (Final Approval) - YELLOW Applicant (Conditional Approval) - PINK