IREDELL COUNTY HEALTH DEPARTMENT

STATESVILLE 704-878-5305 #130 (CT) MOORESVILLE 704-664-5281

IMPROVEMENT PERMIT / AUTHORIZATION TO CONSTRUCT / OPERATION PERMIT / EXISTING SYSTEM INSPECTION

PERMIT# 112759 PIN# ~~4748-20-8265.2~~ 4748-30-6758 DATE Sept 8, 03

OWNER OR CONTRACTOR Dixieland Inc PHONE: Business _____ Home _____

ADDRESS 823 Jennings Rd. Statesville, N.C. 28625

LOCATION 21 N TL Jennings Rd. on left past Sand Lane & before Sunsweet Ln.

SUBDIVISION Deer Crossing BLOCK / SECTION 1 LOT 2 LOT AREA .4591 ac SITE CLASS. PS DESIGN FLOW 360gpd L.T.A.R. .25-.3

Septic Tank: 1000 Gallons: STB 825 Date 12-20-03
Pump Tank: 1000 Gallons: PT 302 Date 5-9-03
Pump Make: Zoller Model N137 Serial No. -
Nitrification Field: No Fields 1 Square Feet 1050 Linear Feet 350
No Lines 4 Trench Width 36" Max Trench Bottom Depth 36" Gravel Depth NA

☑ New System ☐ Repair System Type: I, II, III, IV, V, VI
System Description: 9m-25% Reduction
Repair System Description: LPPBPS
Maintenance Agreement Required: ☐ Yes ☑ No initially

☑ House/Mod. Home No. Bedrooms 3
☐ Mobile Home No. Bathrooms 2
☐ Business No. Employees ____
☐ Other _____
☐ Slab ☑ Crawl Space ☐ Basement w/plumbing ☐ Basement wo/plumbing


Water Supply: ☐ Individual ☑ Public ☐ Community

Comments:/Conditions: Do not cut around house!
Pump Specs: 36gal/min @ approx. 28'TDH

Comments:/Conditions: -poly/ok filter installed
-58 Infiltrator Chambers Installed, liner + Presure check o Kay 3/4/04

1"=50'

INITIAL SITE SKETCH

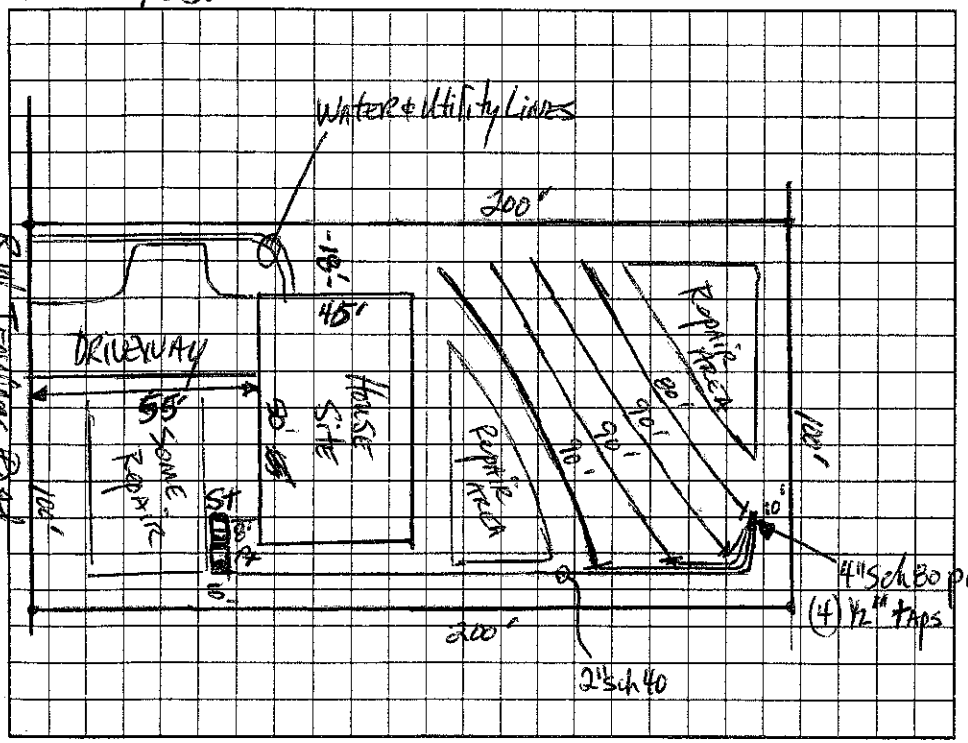

AS BUILT SKETCH

Installed as Shown per Initial Site Sketch

Permit can be suspended or revoked if any false information is supplied toward securing the permit/any unauthorized changes are made to the site/any unauthorized changes are made in the installation of the system. Improvement Permit with plat valid without expiration. Improvement Permit with site plan valid for sixty months. Authorization to Construct is valid for a period equal to that of Improvement Permit – not to exceed sixty months.

Signed: Regina Cecil date 9/29/03 Installed by: Rowan Septic + Grading

Improvement Permit by: Chad Harmon, PS date 9-8-03 Operation Permit by: STEVE HENDRICK date 6-16-04

Authorization to Construct by: STEVE HENDRICK date 11-7-03 Existing System Inspection by: _____ date _____

HEALTH DEPT. COPY: WHITE OWNER COPY (FINAL): YELLOW OWNER COPY (INITIAL): PINK