IREDELL COUNTY HEALTH DEPARTMENT

STATESVILLE 704-878-5305 (O) MOORESVILLE 704-664-5281

IMPROVEMENT PERMIT / AUTHORIZATION TO CONSTRUCT / OPERATION PERMIT / EXISTING SYSTEM INSPECTION

PERMIT # 157498 PIN # 4748-30-6828 DATE 7-21-09

OWNER or APPLICANT Dixieland Construction PHONE: Business 704 202 4971 Home:

OWNER or APPLICANT ADDRESS 823 Jennings Rd.

LOCATION / DIRECTIONS Jennings Rd North, pass Spud Lane, on left, just before Sunswept Loop (753 Jennings Road)

SUBDIVISION Deer Crossing BLOCK / SECTION LOT # 1 LOT AREA .49 DESIGN FLOW 360 L.T.A.R. .25

Septic Tank 1000 Gallons: STB 825 Date 7-5-09
Pump Tank 1000 Gallons: P T 302 Date 6-2-09
Pump Make Zoeller Model BN 152 0 Serial # 52-005
Nitrification Field No Fields 1 No Lines 4 Linear Feet 360'
Trench Width 36" Max. Trench Bottom Depth 36" Gravel Depth n/a ☐ GRAVITY ☒ PRESSURE

☒ New System ☐ Repair ☐ Expansion System Type I II (III) IV V VI
System Description: Pump 25% Reduction
Repair System Description: Pump 50% Reduction
Maintenance Agreement Required ☐ YES ☒ NO


☒ Residence No. Bedrooms 3
☐ Business No. Persons
☐ Other No. Employees
☐ Slab ☒ Crawl Space
☐ Basement w/plumbing ☐ Basement w/o plumbing

Water Supply: ☐ Private ☒ Public ☐ Community


Comments / Conditions
(4) 3' x 90'

Comments / Conditions
8-27-09 Blue Surface title
septic marks
pump was
time checked

INITIAL SITE SKETCH

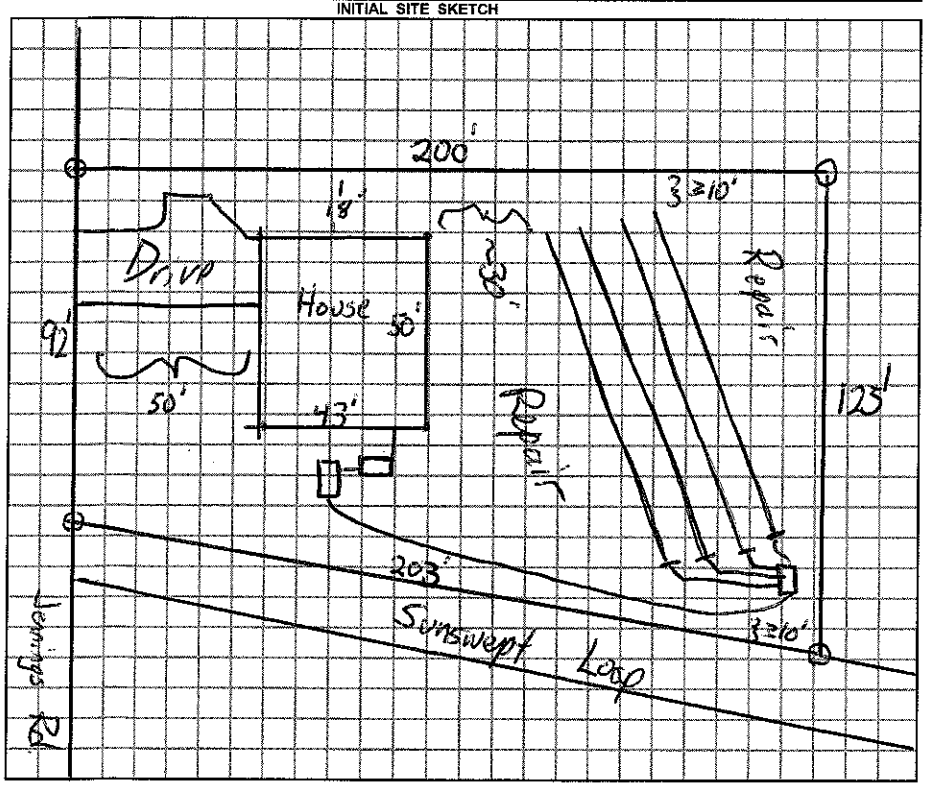

AS-BUILT SKETCH

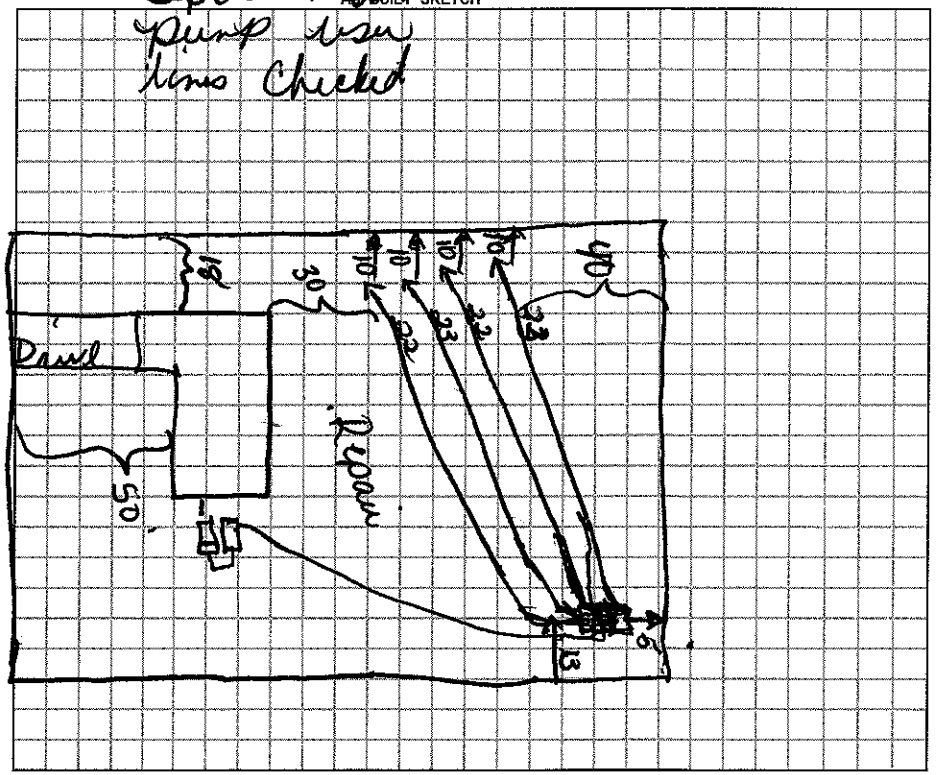

Permit can be suspended or revoked if any false information is supplied toward securing the permit / any unauthorized changes are made to the site / any unauthorized changes are made in the installation of the system.

☐ *IMPROVEMENT PERMIT w / plat valid without expiration* ☒ *IMPROVEMENT PERMIT w / site plan valid for 60 mos.* ☒ *AUTHORIZATION TO CONSTRUCT valid for period equal to IMPROVEMENT PERMIT-not to exceed 60 mo.*

Owner / Applicant Signature: Kenna Dardie Date 7/21/09
Improvement Permit by: James Date 7-21-09
Authorization to Construct by: James Date 7-21-09

Installed by: Ryan Septic
Operation Permit by: James Date: 9-28-09
Existing System Inspected by: Date:

YOU SHOULD CONTACT A LOCATOR SERVICE PRIOR TO ANY EXCAVATION.

WHITE COPY Environmental Health YELLOW COPY (Final) Owner / Applicant PINK COPY (Initial) Owner / Applicant