IREDELL COUNTY HEALTH DEPARTMENT

STATESVILLE 704-878-5305 MOORESVILLE 704-664-5281

IMPROVEMENT PERMIT / AUTHORIZATION TO CONSTRUCT / OPERATION PERMIT / EXISTING SYSTEM INSPECTION

PERMIT# 136962 PIN# 4748307196 DATE 8-15-06

OWNER OR APPLICANT Dixieland, Inc. PHONE: Business 704 876 6162 Home

ADDRESS 261 Sundance Circle

LOCATION Jennings Rd (L) on Deer Haven, left on Sundance Circle, property on left

SUBDIVISION Deer Crossing BLOCK / SECTION IV LOT 37 LOT AREA .463 SITE CLASS. PS DESIGN FLOW 360 L.T.A.R. .3

Septic Tank: 1000 Gallons; STB 825 Date 9-28-86
Pump Tank: 1000 Gallons; PT 307 Date 9-14-00
Pump Make: Zoeller Model N152 Serial No.
Nitrification Field: No Fields 1 Square Feet 1200 Linear Feet 300
No Lines 3 Trench Width 36" Max Trench Bottom Depth 36"

☐ New System ☐ Repair ☐ Expansion System Type: I II (III) IV V VI
System Description: 25% Reduction Pump
Repair System Description: 50% Reduction LP
Maintenance Agreement Required: ☐ Yes ☒ No

☒ House/Mod. Home No. Bedrooms 3
☐ Mobile Home No. Persons
☐ Business No. Employees
☐ Other


Water Supply: ☐ Individual ☐ Public ☐ Community

Gravel Depth N/A ☐ Gravity ☒ Pressure ☐ Slab ☐ Crawl Space ☐ Basement w/plumbing ☐ Basement wo/plumbing

Comments/Conditions:

Comments/Conditions:
Blue/White Filter

INITIAL SITE SKETCH

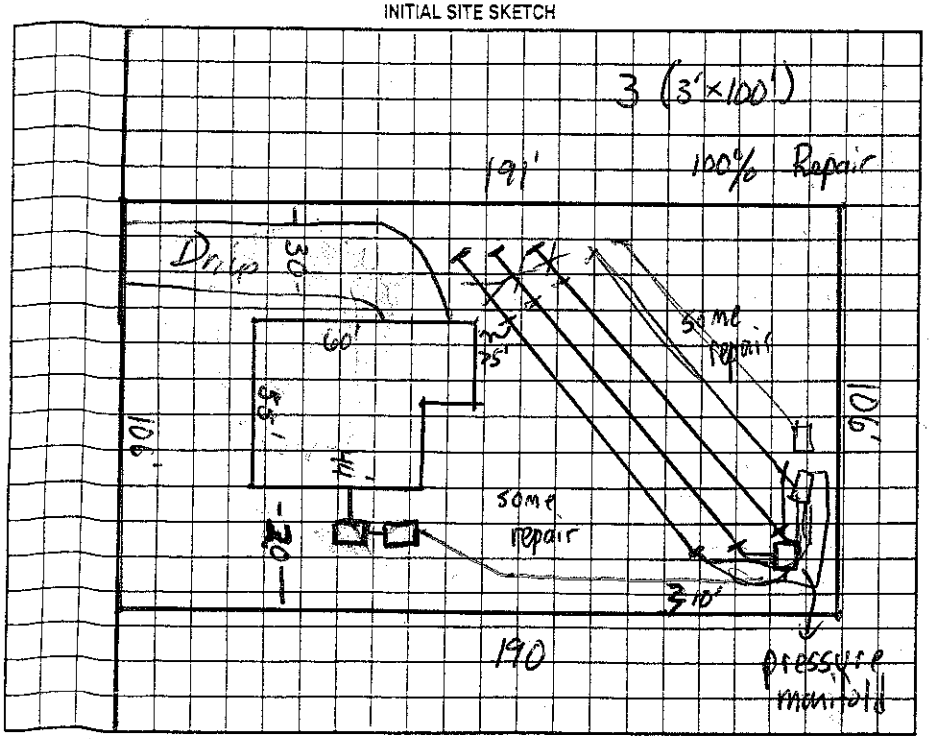

AS BUILT SKETCH

Permit can be suspended or revoked if any false information is supplied toward securing the permit/any unauthorized changes are made to the site/any unauthorized changes are made in the installation of the system. Improvement Permit with plat valid without expiration ☐ Improvement Permit with site plan valid for sixty months ☐ Authorization to Construct is valid for a period equal to that of Improvement Permit – not to exceed sixty months.

Signed: [signature] date 8-15-06 Installed by: Kawa Septic

Improvement Permit by: [signature] date 8-15-06 Operation Permit by: [signature] date 11-20-06

Authorization to Construct by: [signature] date 8-15-06 Existing System Inspection by: date

HEALTH DEPT. COPY: WHITE OWNER COPY (FINAL): YELLOW OWNER COPY (INITIAL): PINK