IREDELL COUNTY HEALTH DEPARTMENT

STATESVILLE 704-878-5305 MOORESVILLE 704-664-5281

IMPROVEMENT PERMIT / AUTHORIZATION TO CONSTRUCT / OPERATION PERMIT / EXISTING SYSTEM INSPECTION

CI

PERMIT# 139270 PIN# 4748307202 DATE 12-27-06

OWNER OR APPLICANT Dixieland Inc. PHONE: Business 704 202 4971 Home 704 876 6162

ADDRESS 255 Syndance Circle

LOCATION Jennings Rd N, left into Deer Haven, left Sundance Circle, property on left

SUBDIVISION Deer Cross BLOCK / SECTION 3&4 LOT 3e LOT AREA SITE CLASS. PS DESIGN FLOW 360 L.T.A.R. .3

Septic Tank: 1500 Gallons; STB 325 Date 3-1-07

Pump Tank: Gallons; PT Date

Pump Make: Model Serial No.

Nitrification Field: No Fields 1 Square Feet 1200 Linear Feet 30

No Lines 4 Trench Width 36" Max Trench Bottom Depth 36" Gravel Depth

☒ New System ☐ Repair ☐ Expansion System Type: I II III IV V VI

System Description: 25% Reduction Gravity

Repair System Description: 50% Reduction LP

Maintenance Agreement Required: ☐ Yes ☒ No

☒ House/Mod. Home No. Bedrooms 3

☐ Mobile Home No. Persons

☐ Business No. Employees

☐ Other

Water Supply: ☐ Individual ☒ Public ☐ Community


☒ Gravity ☐ Pressure ☐ Slab ☒ Crawl Space ☐ Basement w/plumbing ☐ Basement wo/plumbing

Comments:/Conditions:


25 from house foundation with septic lines min.

Comments:/Conditions:

INITIAL SITE SKETCH

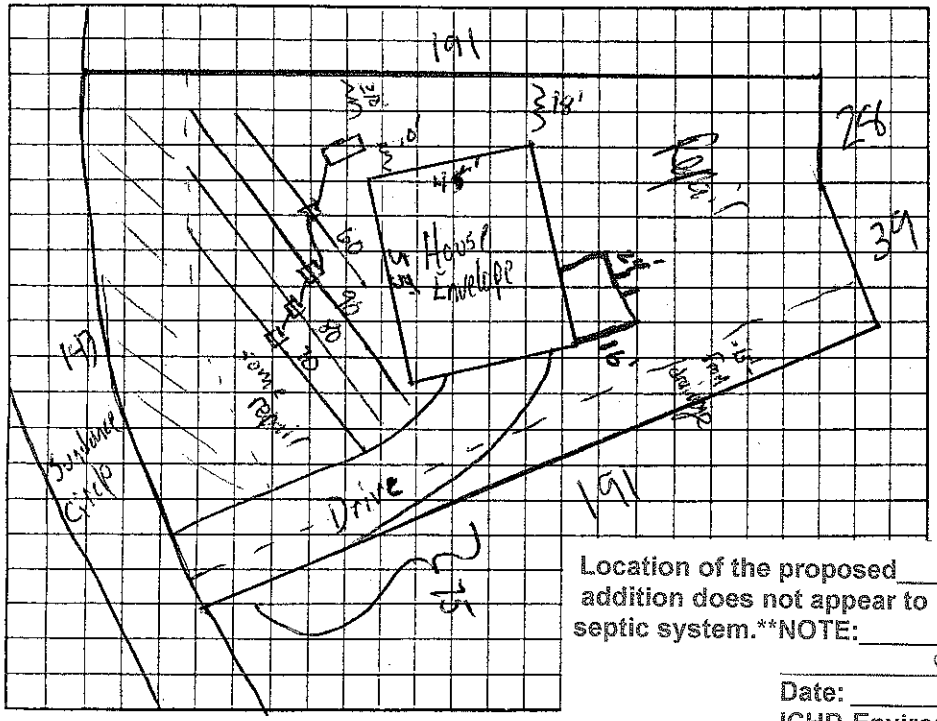

AS BUILT SKETCH

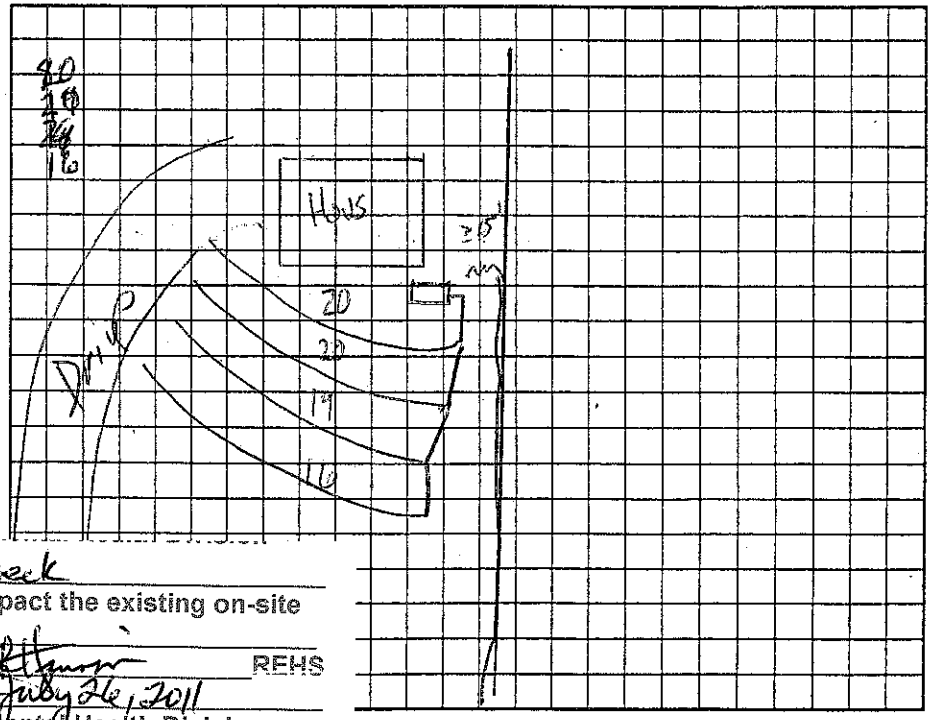

Location of the proposed Deck addition does not appear to impact the existing on-site septic system.**NOTE: REHS

Date: July 26, 2011

ICHD-Environmental Health Division

Permit can be suspended or revoked if any false information is supplied toward securing the permit/any unauthorized changes are made to the site/any unauthorized changes are made in the installation of the system. Improvement Permit with plat valid without expiration ☐ Improvement Permit with site plan valid for sixty months ☒ Authorization to Construct is valid for a period equal to that of Improvement Permit – not to exceed sixty months.

Signed: Kayna Donzlo date 12-27-06 Installed by: Raven Septic

Improvement Permit by: James date 12-27-06 Operation Permit by: James date 3-24-07

Authorization to Construct by: James date 12-27-06 Existing System Inspection by: date

HEALTH DEPT. COPY: WHITE OWNER COPY (FINAL): YELLOW OWNER COPY (INITIAL): PINK