D Clark Dunn Enterprises

2065555 130.00 Paid

IREDELL COUNTY HEALTH DEPARTMENT

STATESVILLE 704-878-5305 (a) MOORESVILLE 704-664-5281

IMPROVEMENT PERMIT / AUTHORIZATION TO CONSTRUCT / OPERATION PERMIT / EXISTING SYSTEM INSPECTION

PERMIT# 112802 PIN# 4748-20-8265.4 4748-30-7528

OWNER OR CONTRACTOR Dixieland Inc DATE July 23, 03

ADDRESS 823 Jennings Rd Statesville, NC 28625 PHONE: Business Home

LOCATION From Statesville 21N TL Jennings Rd. first Speed Lane on left

SUBDIVISION Deer Crossing BLOCK / SECTION 1 LOT 9 LOT AREA .49ac SITE CLASS. P5 DESIGN FLOW 360 gpd L.T.A.R. .25

Septic Tank: 1000 Gallons: STB 825 Date 3-1-03

Pump Tank: Gallons: PT Date

Pump Make: Model Serial No.

Nitrification Field: No Fields 1 Square Feet 1080 Linear Feet 360

No Lines 5 Trench Width 36" Max Trench Bottom Depth 20"

☑ New System ☐ Repair System Type: I, II, III, IV, V, VI

System Description: Gravity Shallow 25% Reduction

Repair System Description: LPP or LP Shallow 25% Red.

Maintenance Agreement Required: ☐ Yes ☑ No initially

Gravel Depth NK

☑ House/Mod. Home No. Bedrooms 3

☐ Mobile Home No. Bathrooms 2

☐ Business No. Employees

☐ Other


☐ Slab ☑ Crawl Space ☐ Basement w/plumbing ☐ Basement wo/plumbing

Water Supply: ☐ Individual ☑ Public ☐ Community

Comments:/Conditions:

Comments:/Conditions: SEPTIC TANK WITH MARKER INSTALLED USING "POLY LOK" FILTER

1"=50' INITIAL SITE SKETCH

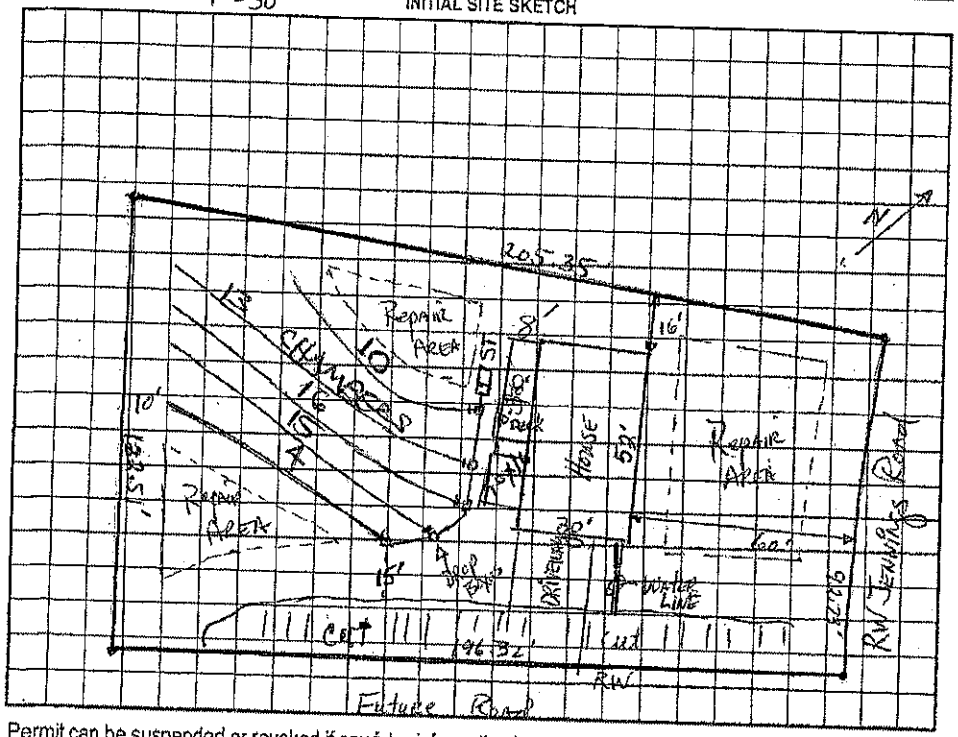

AS BUILT SKETCH

Location of the proposed 8'X30' kitchen addition does not appear to impact the existing on-site septic system or well.**NOTE:

REHS Date: 10/27/14

ICHD-Environmental Health Division

Permit can be suspended or revoked if any false information is supplied toward securing the permit/any unauthorized changes are made to the site/any unauthorized changes are made in the installation of the system. Improvement Permit with plat valid without expiration. Improvement Permit with site plan valid for sixty months. Authorization to Construct is valid for a period equal to that of Improvement Permit – not to exceed sixty months.

Signed: Regina Beard

Improvement Permit by: date 7/24/03

Authorization to Construct by: date 7-23-03

Installed by: Rowan Septic

Operation Permit by: Steve Hedrick date 9-2-03

Existing System Inspection by: date

HEALTH DEPT. COPY: WHITE OWNER COPY (FINAL): YELLOW OWNER COPY (INITIAL): PINK