IREDELL COUNTY HEALTH DEPARTMENT

Statesville Office (704) 878-5305 Mooresville Office (704) 660-3625 PERMIT # 210810

IMPROVEMENT PERMIT / AUTHORIZATION TO CONSTRUCT / OPERATION PERMIT / EXISTING SYSTEM

PIN # 4748307528

APPLICANT: Banana Fish LLC APPLICANT ADDRESS: 9222 Monroe Rd.

SITE ADDRESS: 741 Jennings Rd. PHONE: 704-321-2997 ALT. PHONE: N/A

SITE DIRECTIONS: Hwy 21 N TL Jennings Rd. Property on Left at Corner of Jennings & Deer Haven


SUBDIVISION: Deer Crossing SECTION: P1 LOT # 4 LOT AREA: 0.49 acres DESIGN FLOW: 360gpd L.T.A.R.: Existing

Septic Tank: Existing (gal)	STB	Date	☐ New System ☐ Repair ☐ Expansion System Type: I ☑ II III IV V VI	☑ Residence	No. Bedrooms: 3	Water Supply: ☐ Private
Pump Tank (gal)	PT	Date	System Description: Existing	☐ Business	No. Persons: 6	☑ Public
Pump Make	Model	Serial #	Repair System Description:	☐ Other	No. Employees	☐ Community
# Nitrification Fields: Ex	# Lines: Ex	Linear Ft: Ex	Maintenance Agreement Required: ☐ YES ☑ NO	☐ Slab	☑ Crawl Space	
Trench Width: Ex	Max. Trench Bottom Depth: Ex	Gravel Depth: Ex	☑ GRAVITY ☐ PRESSURE	☐ Basement w/plumbing	☐ Basement w/o plumbing	


Comments / Conditions:

- maintain a minimum of 15' between pool & all components of septic tank system and repair areas.

INITIAL SITE SKETCH

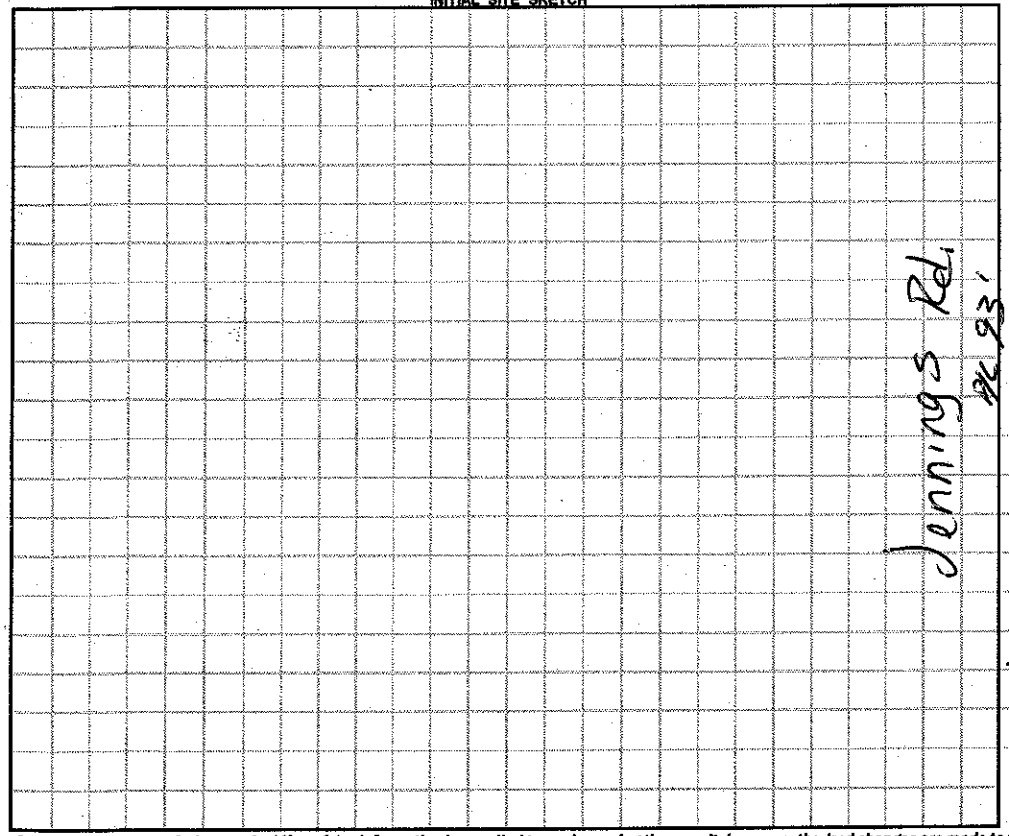

AS BUILT SKETCH

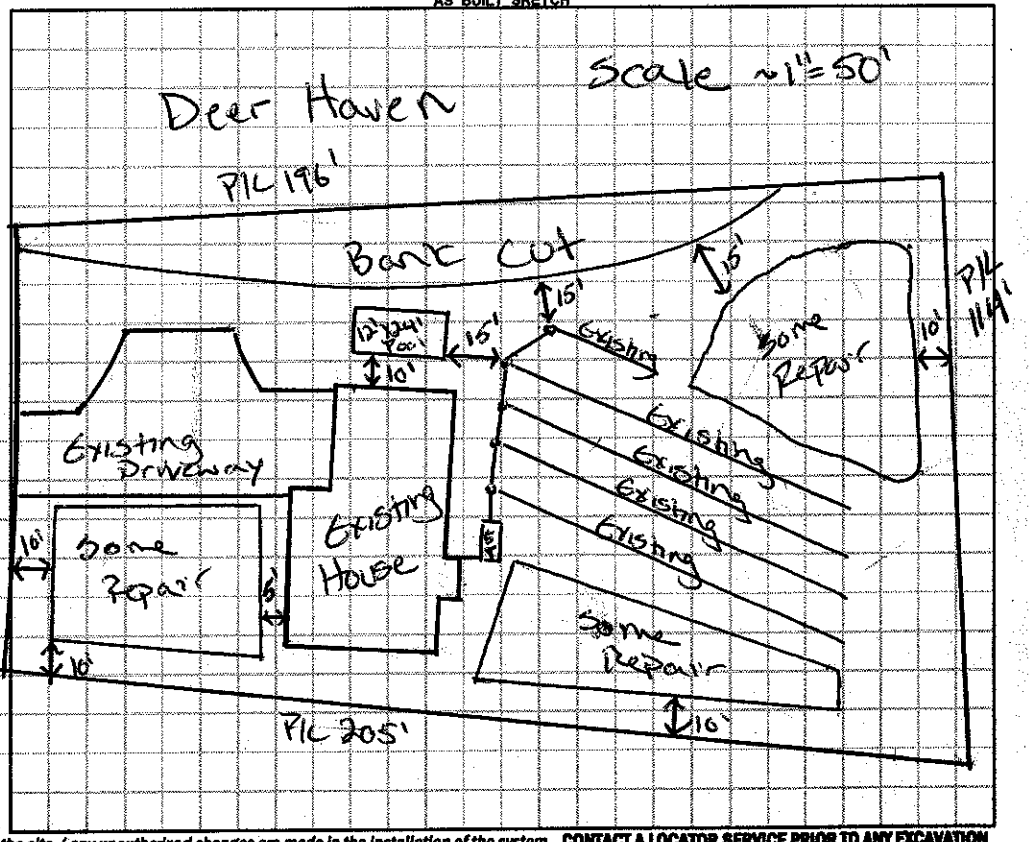

Permit can be suspended or revoked if any false information is supplied toward securing the permit / any unauthorized changes are made to the site / any unauthorized changes are made in the installation of the system. **CONTACT A LOCATOR SERVICE PRIOR TO ANY EXCAVATION**

☐ **IMPROVEMENT PERMIT** *with plat valid without expiration.* ☐ **IMPROVEMENT PERMIT** *with site plan valid for 60 mos.* ☐ **AUTHORIZATION TO CONSTRUCT** *valid for period equal to IMPROVEMENT PERMIT--not to exceed 60 mo.*

Owner / Applicant Signature: Carrie C Nitzer Date: 6-10-15 Installed by:

IMPROVEMENT PERMIT by: Date: OPERATION PERMIT by: Date:

AUTHORIZATION TO CONSTRUCT by: Date: Existing System Inspected by: Justin D Henderson Date: 6-10-15

Health Dept. Copy - WHITE Applicant (Final Approval) - YELLOW Applicant (Conditional Approval) - PINK