IREDELL COUNTY HEALTH DEPARTMENT

CI

STATESVILLE 704-878-5305 MOORESVILLE 704-664-5281

IMPROVEMENT PERMIT / AUTHORIZATION TO CONSTRUCT / OPERATION PERMIT / EXISTING SYSTEM INSPECTION

PERMIT# 112650 PIN# ~~4746-20-8165-E~~ 4746-80-0808 4747-39-8629 DATE July 11, 03

OWNER OR CONTRACTOR Ginger Cecil // Dixie Land Inc. PHONE: Business _____ Home _____

ADDRESS 823 Jennings Rd., Statesville, N.C. 28625

LOCATION From Statesville 21 N. TL Jennings Rd. (N.) on left ¼ mile ± past Spud Lane

~~THE RESERVE~~ SUBDIVISION AT DEER CROSSING BLOCK / SECTION 1 LOT 6 LOT AREA .05 AC SITE CLASS. PS DESIGN FLOW 360 gpd L.T.A.R. .3

Septic Tank: 1000 Gallons; STB 825 Date 6-25-03
Pump Tank: 1000 Gallons; PT _____ Date _____
Pump Make: _____ Model _____ Serial No. _____
Nitrification Field: No Fields 1 Square Feet 900 Linear Feet 300
No Lines 5 @ 60' Trench Width 36" Max Trench Bottom Depth 36"

☑ New System ☐ Repair System Type: I, II, III, IV, V, VI
System Description: pump to PM 25% Reduction
Repair System Description: LPPPBPS
Maintenance Agreement Required: ☐ Yes ☑ No initially
Gravel Depth NA

☑ House/Mod. Home No. Bedrooms 3
☐ Mobile Home No. Bathrooms 3
☐ Business No. Employees _____
☐ Other _____
☐ Slab ☐ Crawl Space ☑ Basement w/plumbing ☐ Basement wo/plumbing


Water Supply: ☐ Individual ☑ Public ☐ Community

Comments:/Conditions: Pump specs. 43 gal/min @ 18' TDH
HD → Okay to move driveway - use (front driveway)

Comments:/Conditions: 1ST LINE 90
2ND LINE 80
3RD LINE 75
4TH LINE 55


1" = 50'

INITIAL SITE SKETCH

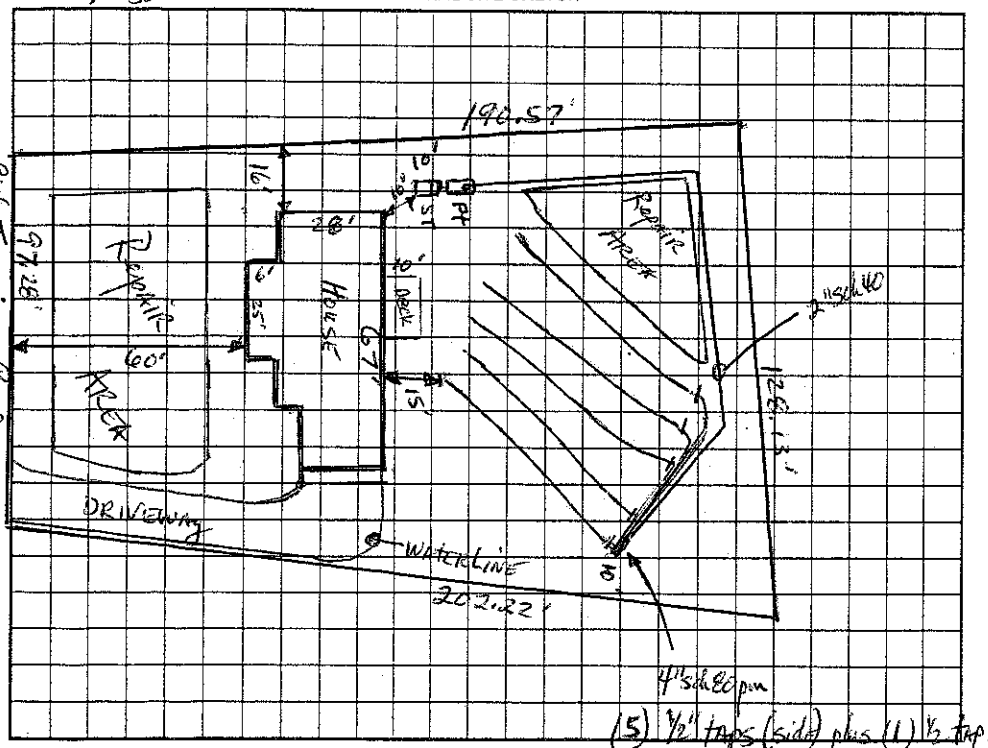

AS BUILT SKETCH

POLYLOK EDITOR + MARLOK CHANGED TO GRAVITY SYSTEMS AS DRAWN BELOW. TANK IS SET WHERE BASEMENT IS TO DAYLIGHT. NO BASEMENT FOUNDATION SETBACK REQUIRED.

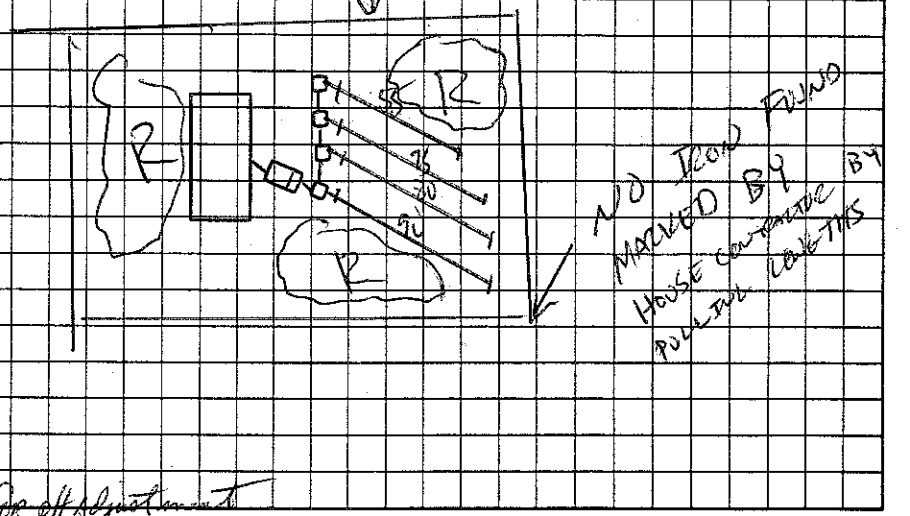

(5) ½" taps (side) plus (1) ½ tap on top for pH adjustment

Permit can be suspended or revoked if any false information is supplied toward securing the permit/any unauthorized changes are made to the site/any unauthorized changes are made in the installation of the system. Improvement Permit with plat valid without expiration. Improvement Permit with site plan valid for sixty months. Authorization to Construct is valid for a period equal to that of Improvement Permit – not to exceed sixty months.

Signed: _____ date 7/16/03 Installed by: ROWAN SEPTIC

Improvement Permit by: _____ date 7-11-03 Operation Permit by: _____ date 9-29-03

Authorization to Construct by: _____ date 7-11-03 Existing System Inspection by: _____ date _____

HEALTH DEPT. COPY: WHITE OWNER COPY (FINAL): YELLOW OWNER COPY (INITIAL): PINK